

RECEIVED

MAY 18 1998

WATER RESOURCES DEPT.
SALEM, OREGON


FINAL PROOF SURVEY UNDER TRANSFER No. T-6988

IN NAME OF: Tom & Sally Bourgeois
PO Box 100
Spray, OR 97874



Scale 1" = 400'

T8S
R24E R25E
1/4

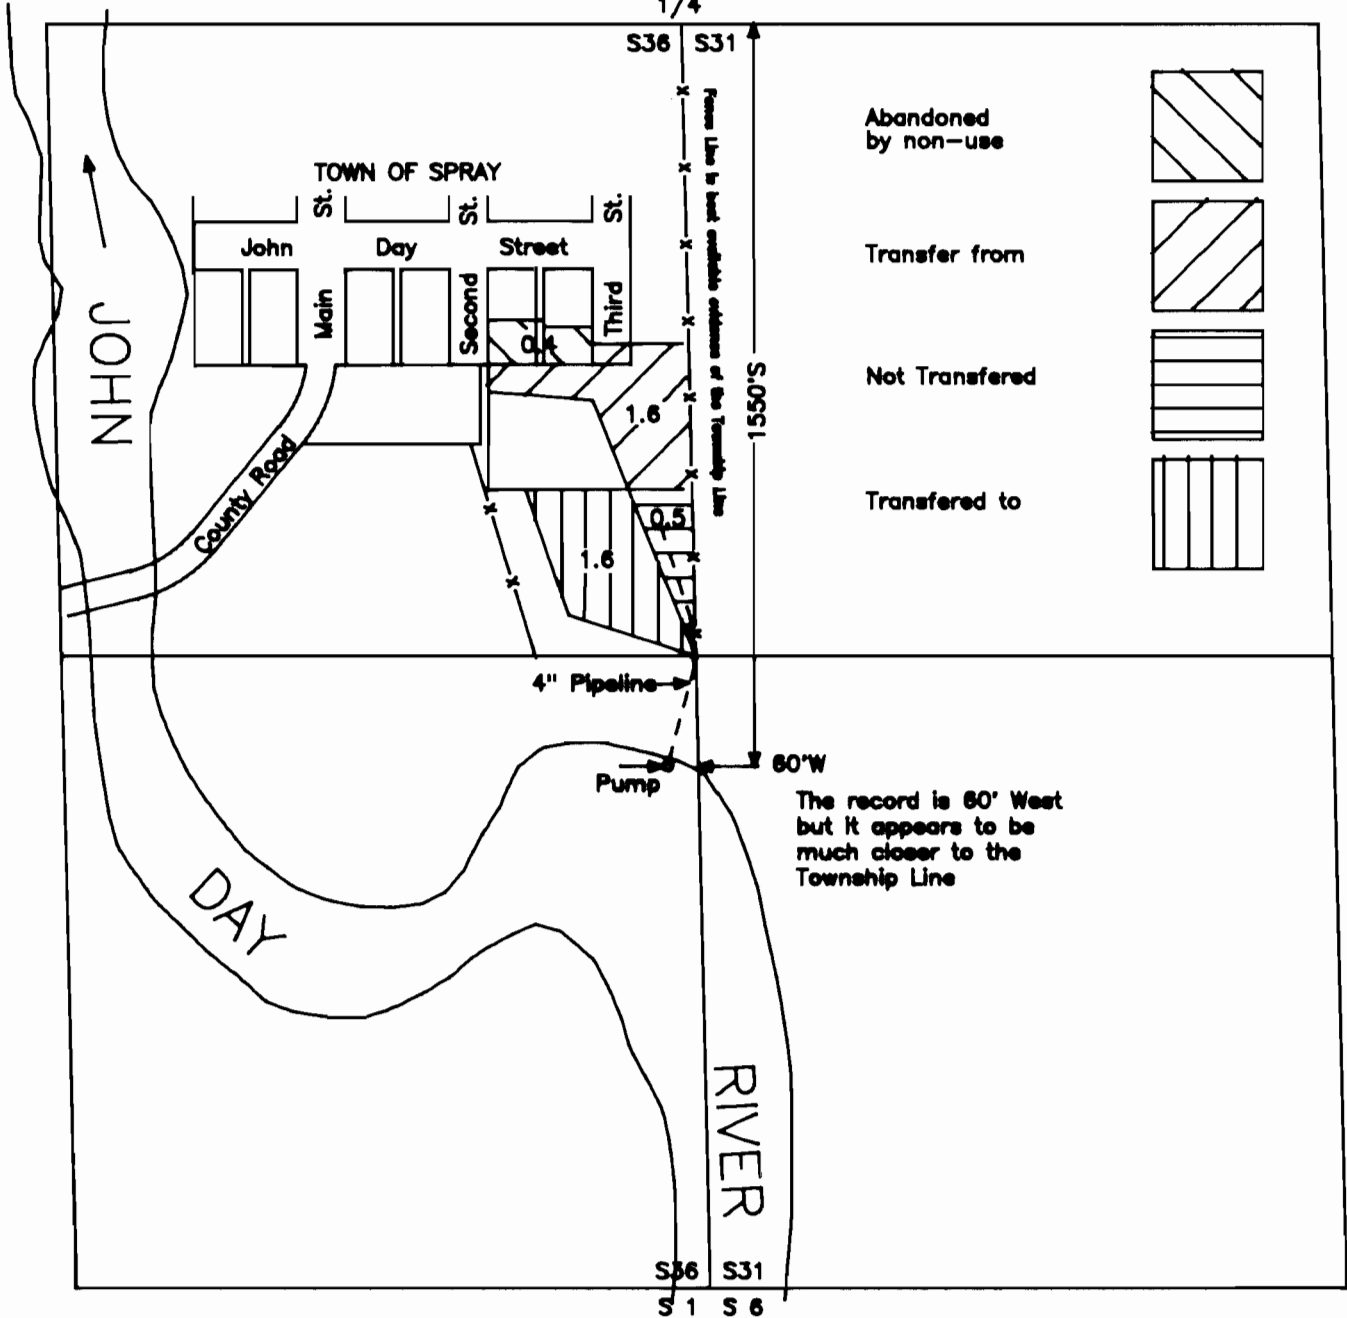

This map is for the purpose of identifying the location of the water right only and has no intent to provide dimensions or location of property ownership lines.

SALEM, OREGON
WATER RESOURCES DEPT.

MAY 18 1998

RECEIVED

WHEELER\BOURGEOIS - 5/5/98