
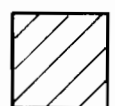


T.9 & 10S. R.3W., W.M

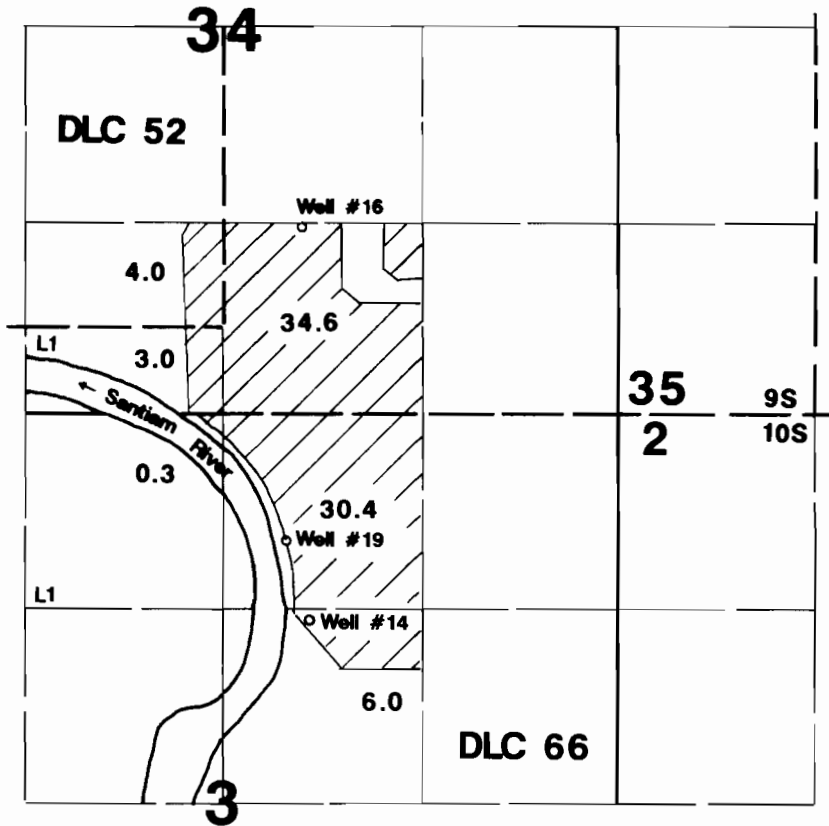

Area Irrigated

Well # 14 (addn'l POD) is located 1400'S & 2100'W from the NE corner of Section 3.
 Well # 16 (addn'l POD) is located 1270'N & 2115'W from the SE corner of Section 34.
 Well # 19 (addn'l POD) is located 840'S & 2220'W from the NE corner Section 3.

RECEIVED

JUL 06 1998

WATER RESOURCES DEPT.
 SALEM, OREGON

Final Proof Survey

Transfer #: T-6891

In Name Of

Iverson Brothers

Surveyed on June 29, 1998 by JM Schuette

This Map Was Prepared For The Purpose Of Identifying The Location Of A Water Right Only And Is Not Intended To Provide Legal Dimensions Or Location Of Property Ownership Lines.

