


T. 2 N., R. 30 E., W.M.

RECEIVED
AUG 27 1968
WATER RESOURCES DEPT.
SALEM, OREGON

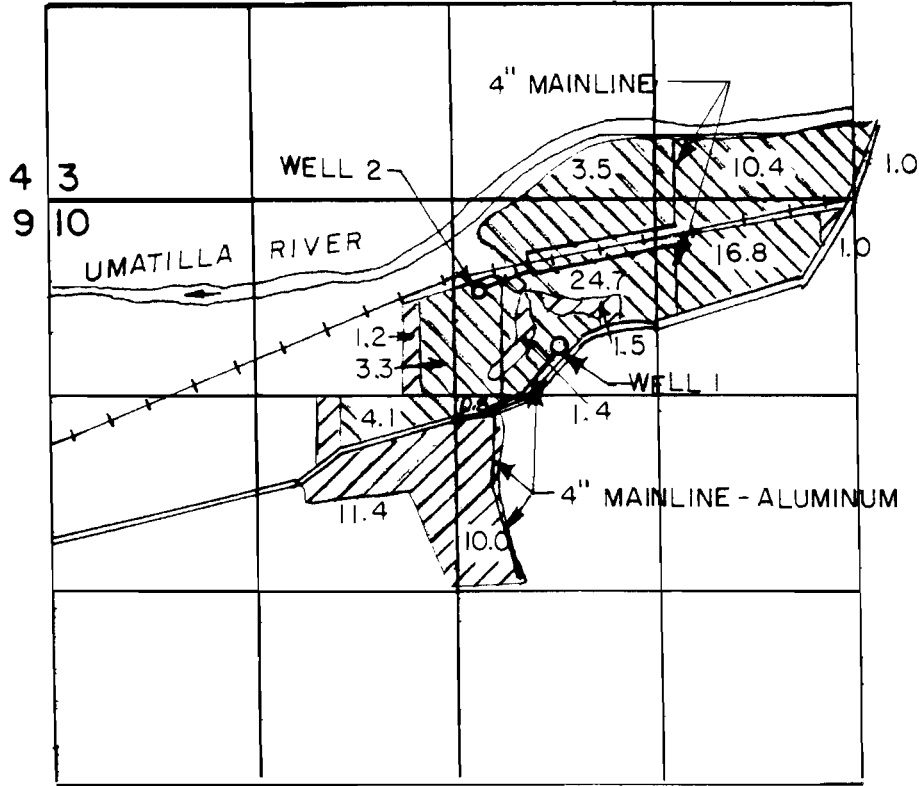

 PRIMARY  SUPPLEMENTAL

WELL 1 - LOCATED 975' S & 750' E FROM THE N 1/4 CORNER, SECTION 10.
WELL 2 - LOCATED 2050' N & 250' E FROM THE CENTER, SECTION 10.

FINAL PROOF SURVEY UNDER

Application No. G-6441 Transfer No. 6845
IN NAME OF

THEODORE A. HENDRICKSON

THIS MAP IS FOR IDENTIFYING THE LOCATION
OF WATER RIGHTS ONLY, AND HAS NO INTENT
TO PROVIDE DIMENSIONS OR LOCATIONS OF
PROPERTY OWNERSHIP LINES.

