


RECEIVED

T.10S. R.4W., W.M

AUG 11 1998

WATER RESOURCES DEPT
SALEM, OREGON

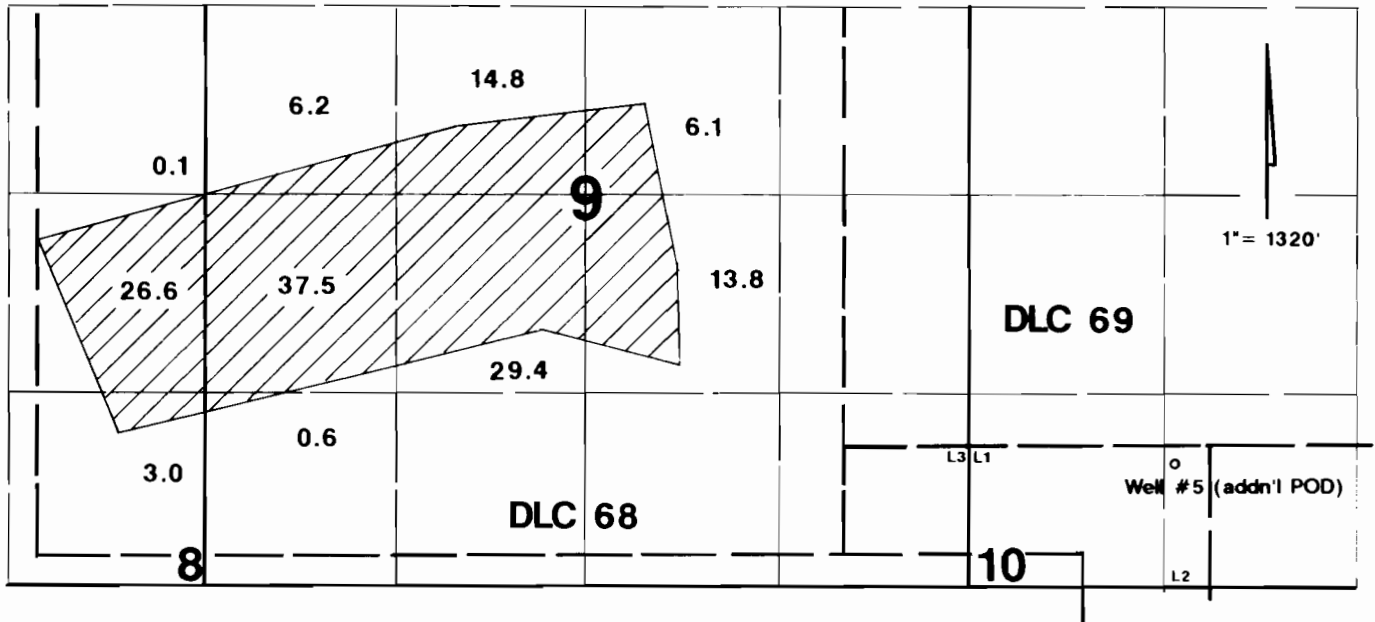

Well # 5 (addn'l POD) is located 850'N & 1400'E from the SW corner of Section 10.



Area Irrigated

Final Proof Survey

Transfer #: T-7270

In Name Of

Russell Underwood

Surveyed on July 24, 1998 by JM Schuette

This Map Was Prepared For The Purpose Of Identifying The Location Of A Water Right Only And Is Not Intended To Provide Legal Dimensions Or Location Of Property Ownership Lines.

