


T. 7 & 8 S. R. 4 W. W.M.

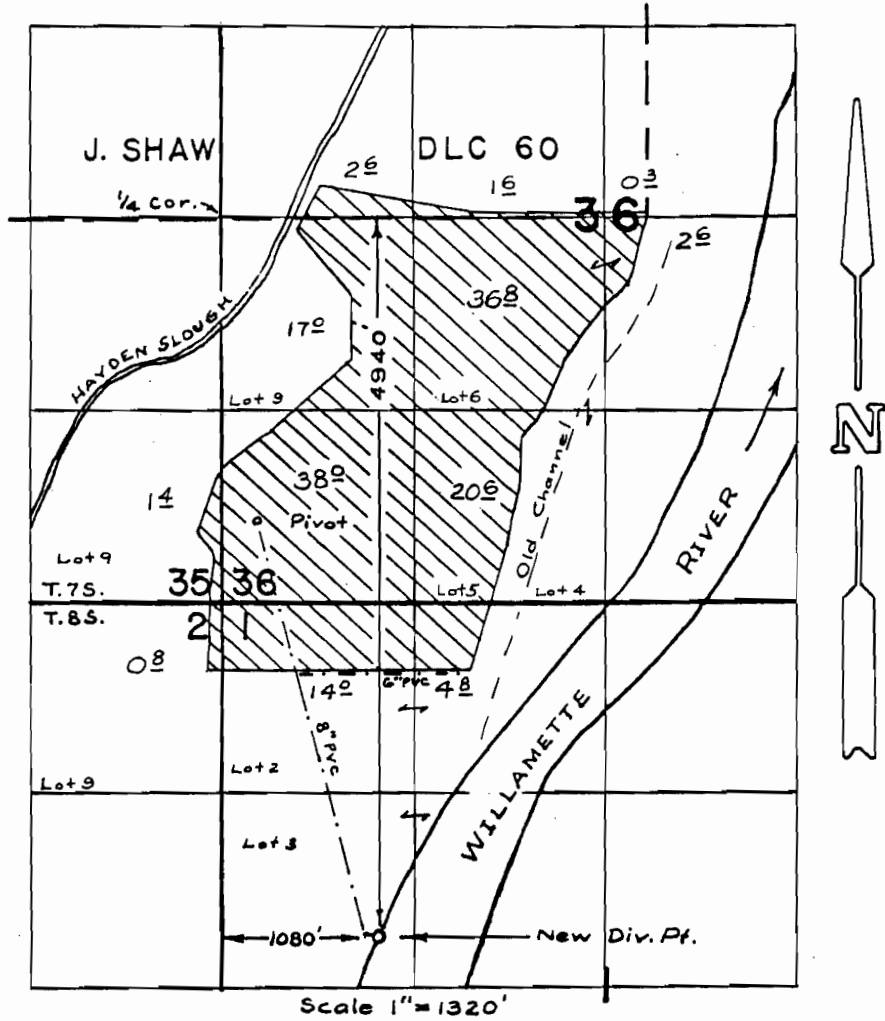

FINAL PROOF SURVEY  
 FOR  
 GREEN VILLA FARMS  
 TRANSFER No. T-6456  
 (PERMIT No. 15237)

THE PREPARATION OF THIS MAP IS FOR THE PURPOSE OF IDENTIFYING THE LOCATION OF THE WATER RIGHT ONLY AND HAS NO INTENT TO PROVIDE DIMENSIONS OR LOCATION OF PROPERTY OWNERSHIP LINES.

