

FINAL PROOF MAP

UNDER



TRANSFER No. T-7371 PERMIT Nos. G-9978 & G-10101

IN THE NAME OF: 1) Rakhra Mushroom Farm Corp.
1000 Washington Street East
Vale, Oregon 97918

2) Ag-Dryers, Inc.
PO Box 280
Vale, Oregon 97918

S20, T18S, R45E

SE1/16

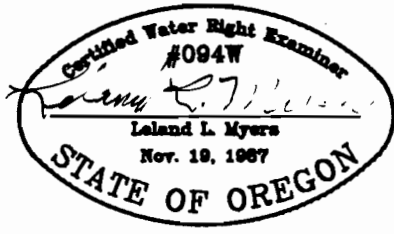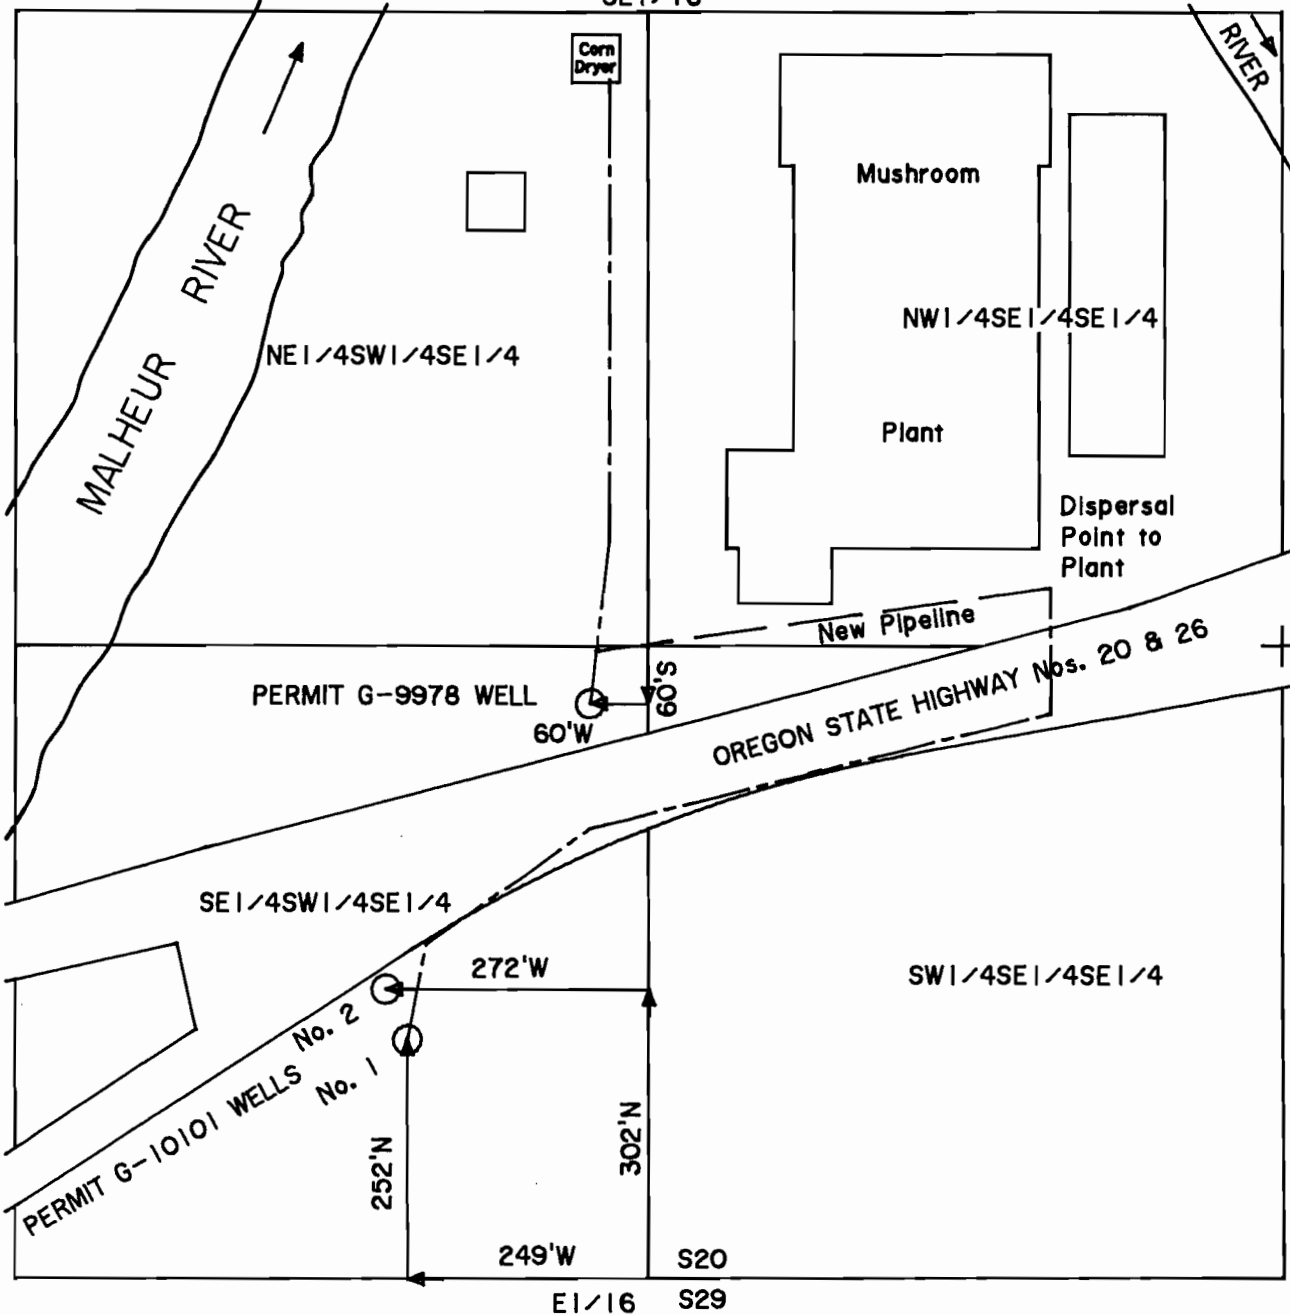

Scale 1" = 200'

This map is for the purpose of identifying the location of the water right only and has no intent to provide dimensions or location of property ownership lines.

RECEIVED

JUL 7 - 1998

WATER RESOURCES DIV
SALEM, OREGON