


TOWNSHIP 14 SOUTH, RANGE 5 WEST, W.M.

RECEIVED

OCT 18 1998

WATER RIGHTS DIVISION
Salem, Oregon

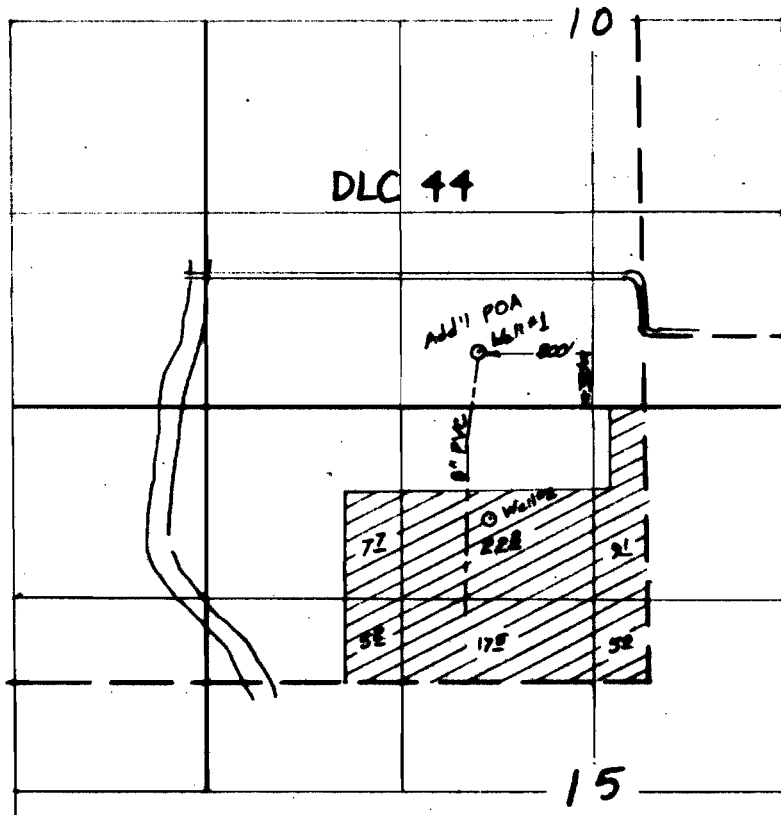

Surveyed September 22, 1997

Claim of Beneficial Use Map
for
CROCKER FARMS

T-6880



This map is for the purpose of
locating a water right only
and has no intent to provide
legal dimensions or the location
of property lines.

ESTES SURVEYS

6888 Sunnyview Rd. NE 60382 Arnold Rd.
Salem, OR 97305 Bend, OR 97702
(503) 588-7888 (503) 588-7881