


RECEIVED

OCT 01 1998

SW1/4NW1/4 SEC. 20, T13S, R29E.

WATER RESOURCES DEPT.
SALEM, OREGON

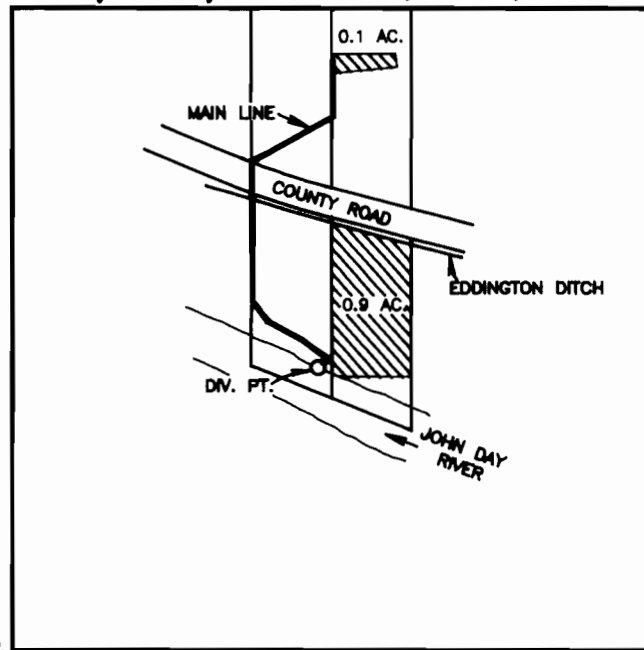

SCALE 1" = 400'

W1/4 COR.

DIVERSION POINT IS 580' N. AND 630' E. OF THE W1/4 COR.

**FINAL PROOF SURVEY
UNDER**

TRANSFER NO. 7138

SPECIAL ORDER VOL. 49, PAGE 263

IN NAME OF
MAX AND IRENE FERGUSON

SURVEYED AUGUST 28, 1998 BY ROBERT D. BAGETT

NOTE: The preparation of this map was for the purpose of identifying the location of the proposed water right and has no intent to provide dimensions or location of property ownership lines.

