
SEP 21 1998

T.11 S. R. 2 W., W.M.

WATER RESOURCES DEPT. SALEM, OREGON

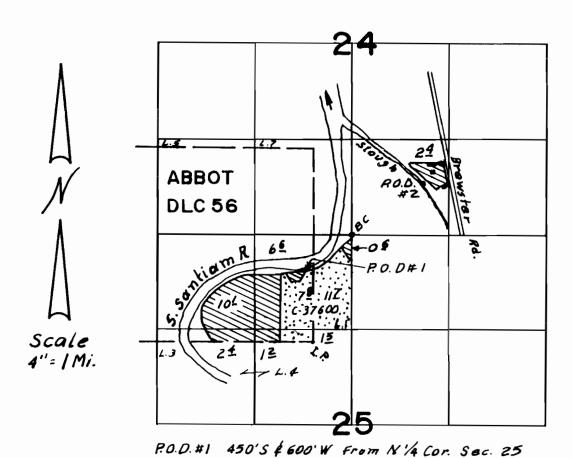

P.O.D.#2 700'N & 980'E

FINAL PROOF SURVEY UNDER

T- 7397 Application No. 82557. Permit No. 52860. IN NAME OF

WAYNE & SHIRLEY CALL

THIS MAP WAS PREPARED FOR THE PURPOSE OF IDENTIFYING THE LOCA- Surveyed SART. 9. 19.9.8, by TION OF A WATER RIGHT ONLY AND IS NOT INTENDED TO PROVIDE LEGAL DIMENSIONS OR LOCATION OF PROPER-TY OWNERSHIP LINES.