


RECEIVED

SEP 21 1998

WATER RESOURCES DEPT.
SALEM, OREGON

T.11S.R.2W., W.M.

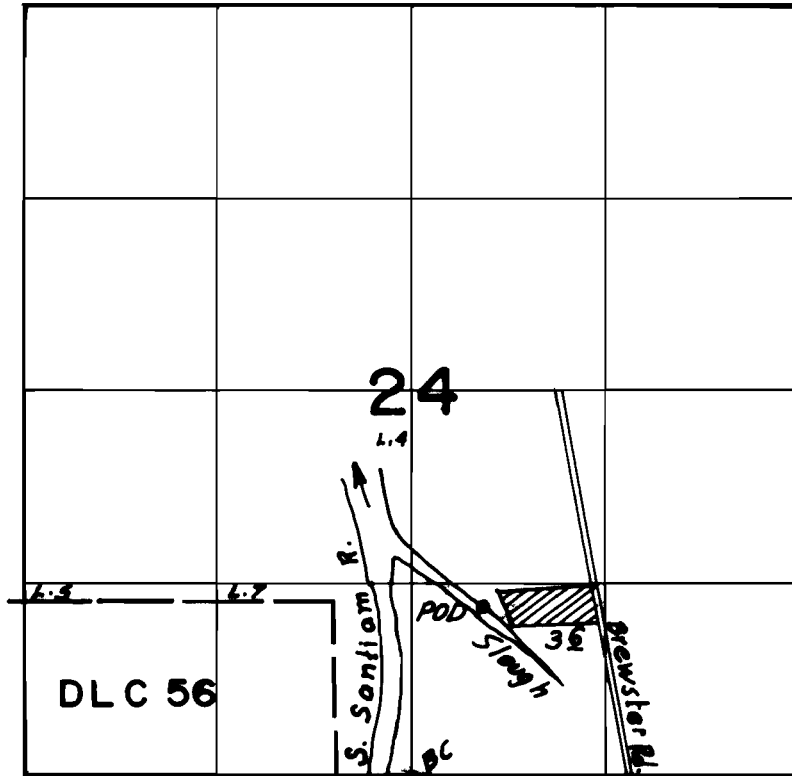

P.O.D. loc. 1140' N & 500' E from SW 1/4 Cor. Sec. 24


FINAL PROOF SURVEY
UNDER

TRANSFER NO. T-7398
Application No. Permit No.

IN NAME OF

WAYNE B. SHIRLEY CALL

Surveyed Sept. 9, 1998, by

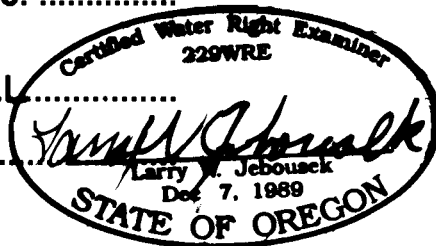

THIS MAP WAS PREPARED FOR THE PURPOSE OF IDENTIFYING THE LOCATION OF A WATER RIGHT ONLY AND IS NOT INTENDED TO PROVIDE LEGAL DIMENSIONS OR LOCATION OF PROPERTY OWNERSHIP LINES.

WAC-990R 5-10