
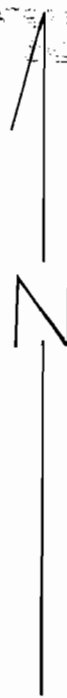


T. 11 S., R. 24 E., W. M.

RECORDED

MAY 4 2 1937

WATER RESOURCES DEPT.
ELEM, OREGON

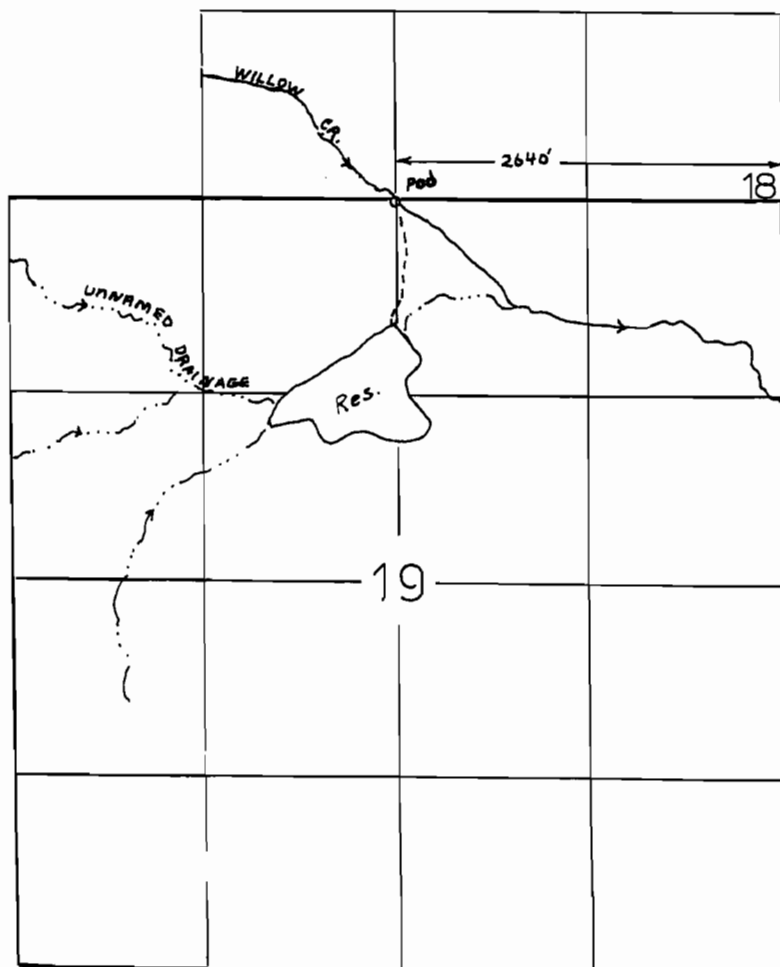

1" = 1320'

FINAL PROOF SURVEY
UNDER

Application No. R-66016. Permit No. R-9397.....
IN NAME OF

.....FRED HARUDA.....

Surveyed Sept. 22 1994, by J. MILLER.....