


Section 16 Township 32 S Range 15 W W.M.  
 Located in the SE 1/4 NW 1/4, SW 1/4 NW 1/4, NE 1/4 SW 1/4, NW 1/4 SW 1/4  
 Curry County, Oregon

**RECEIVED**

JUL 25 1996

WATER RESOURCES DEPT.  
 SALEM, OREGON

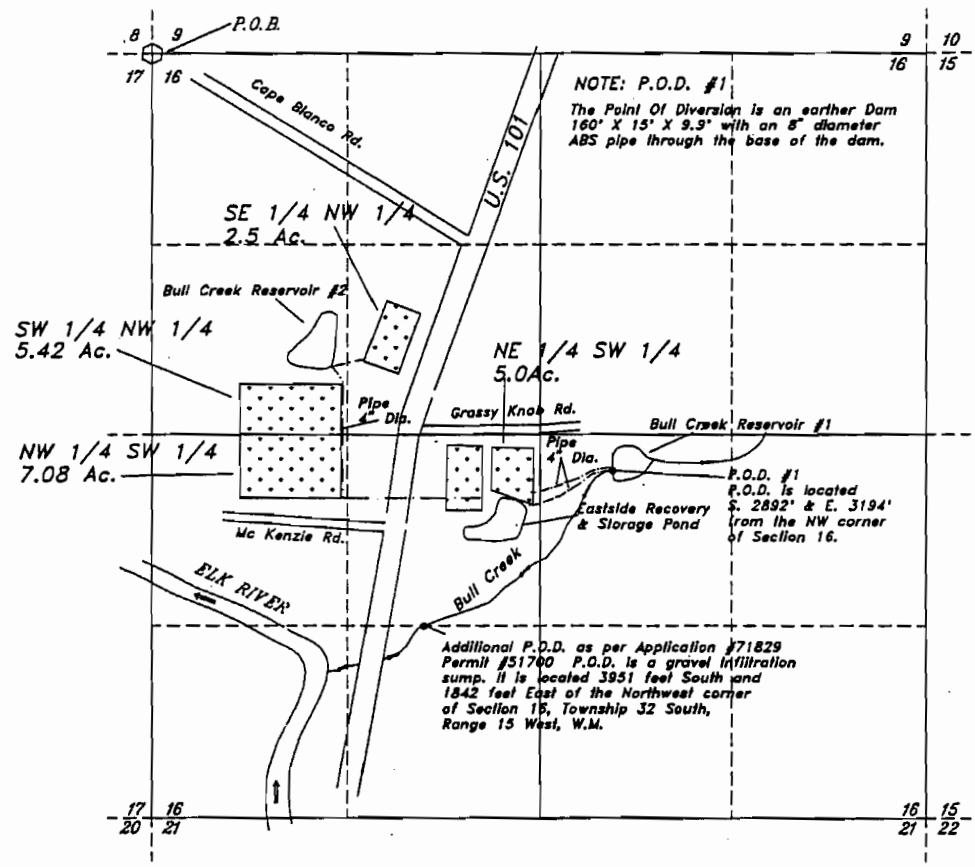

EXAMINERS DISCLAIMER STATEMENT

The preparation of this map was for the purpose of identifying the location of the Water Right only and has no intent to provide dimensions or location of property ownership lines.

**FINAL PROOF SURVEY**  
 IN THE NAME OF

Mary Anne Puhl T-6838

Prepared By: Dennis Coude  
 Surveyed: Aug. 4, 1995

