


T. 32 S., R. 11 W., W.M.

RECEIVED

AUG 27 1999

WATER RESOURCES DEPT.
SALEM, OREGON

DIVERSION IS 5225
FEET SOUTH AND
3980 FEET EAST
OF THE NW CORNER
OF SECTION 25.

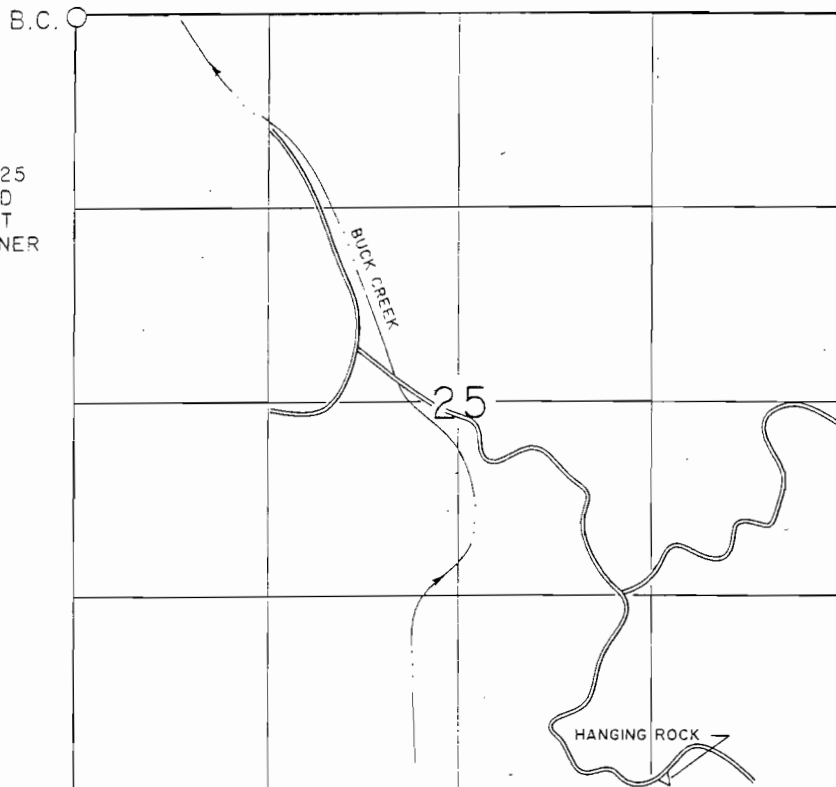

1" = 1320'


CLAIM OF BENEFICIAL USE MAP

IN NAME OF

UNITED STATES BUREAU OF LAND MANAGEMENT

APPLICATION NO. S-78717

PERMIT NO. 52726

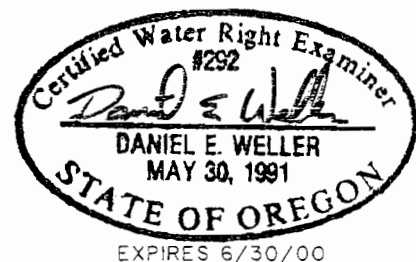

EXPIRES 6/30/00

SURVEYED: JULY 15, 1998

THE PURPOSE OF THIS MAP IS FOR IDENTIFYING THE LOCATION OF THE WATER RIGHT ONLY AND
IS NOT INTENDED TO PROVIDE LEGAL DIMENSIONS OR LOCATION OF PROPERTY OWNERSHIP LINES.

U.S. BUREAU OF LAND MANAGEMENT-OSO
BRANCH OF GEOGRAPHIC SCIENCES

DWG: HANGING

EXECUTED BY:
DANIEL E. WELLER, PLS, CWRE
P.O. BOX 2965
PORTLAND, OREGON 97208