


T13S R30E


AUG 19 1996

WATER RESOURCES DEPT  
SALEM, OREGON

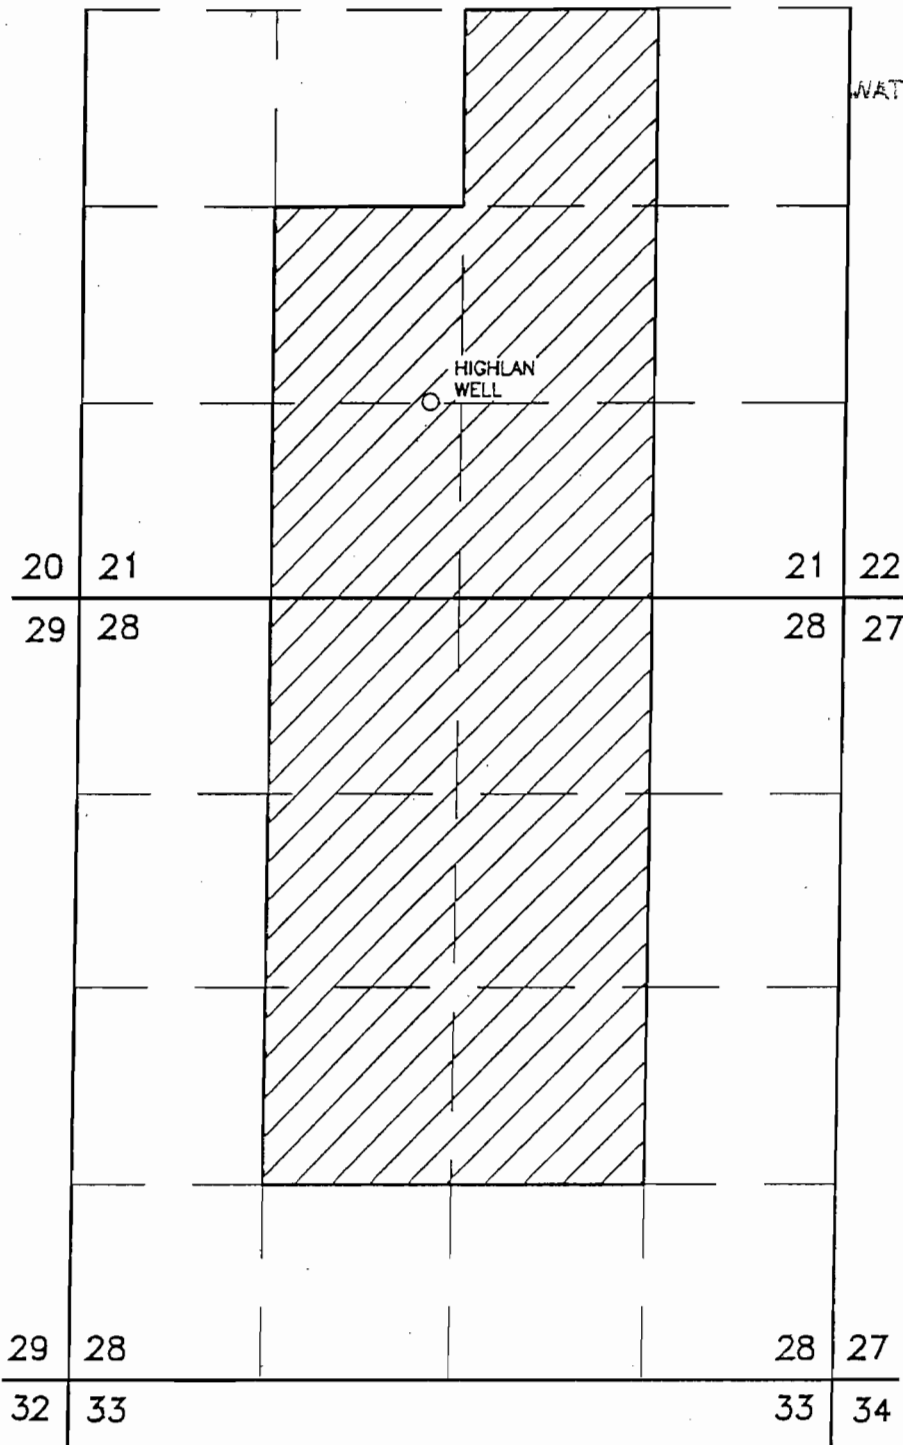

SCALE 1"=1320'

HIGHLAN WELL IS 1330' N. AND 210' W. OF THE S1/4 COR. OF SEC.21

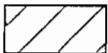

MT. VERNON CITY LIMITS

### FINAL PROOF SURVEY UNDER

T-7234

IN THE NAME OF  
CITY OF MT. VERNON

SURVEYED AUG. 7, 1996 BY R.D. BAGETT

NOTE: THE PREPARATION OF THIS MAP  
WAS FOR THE PURPOSE OF IDENTIFYING  
THE LOCATION OF THE PROPOSED WATER  
RIGHT AND HAS NO INTENT TO PROVIDE  
DIMENSIONS OR LOCATION OF PROPERTY  
OWNERSHIP LINES.



BAGETT-GRIFFITH & BLACKMAN  
P.O. BOX 476  
JOHN DAY, OR. 97845

