

RECEIVED

OCT - 2 1996

WATER RESOURCES DEPT.
SALEM, OREGON



N.E RIVERSIDE AVE.

SW 1/4, SW 1/4

SE 1/4, SW 1/4

6

7

N.E

QUEENS AVE.

6 1/4

7

1

12

NW 1/4, NW 1/4

2.77 ACS.

2.02 ACS.

NE 1/4, NW 1/4

1052
~~1080~~ ACS.

1912 WATER
RIGHT LIMIT

UMATILLA

RIVER

POD, S 12° 15' 00" W
1312.3' FROM 1/4 687

WRD 8-12-10 JWG

KRUMBEIN ENGINEERING LTD.

ENGINEERS - SURVEYORS - PLANNERS
361 S.E. Second Pendleton, Oregon


Scale
1" = 400'
Date
9-27-96

Drn. By
HP
Ckd. By
DHK

Drng. No.
9630A
Job No.
9225

Revision 1
Revision 2

FINAL PROOF MAP &
CLAIM OF BENEFICIAL USE
SPIESS
SECTION 7, T. 2 N., R. 33 E.W.M.

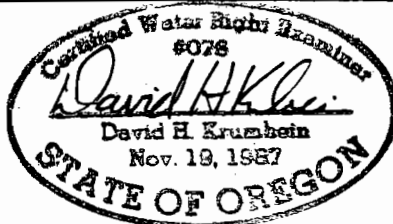

RENEWS 6/30/97

T-6953