

T4S, R10W, Sections 11, 12, 13 & 14 W.M.


Permit S-49685, Application S-68665

Tillamook County

RECEIVED


SEP 03 2010

WATER RESOURCES DEPT  
SALEM, OREGON

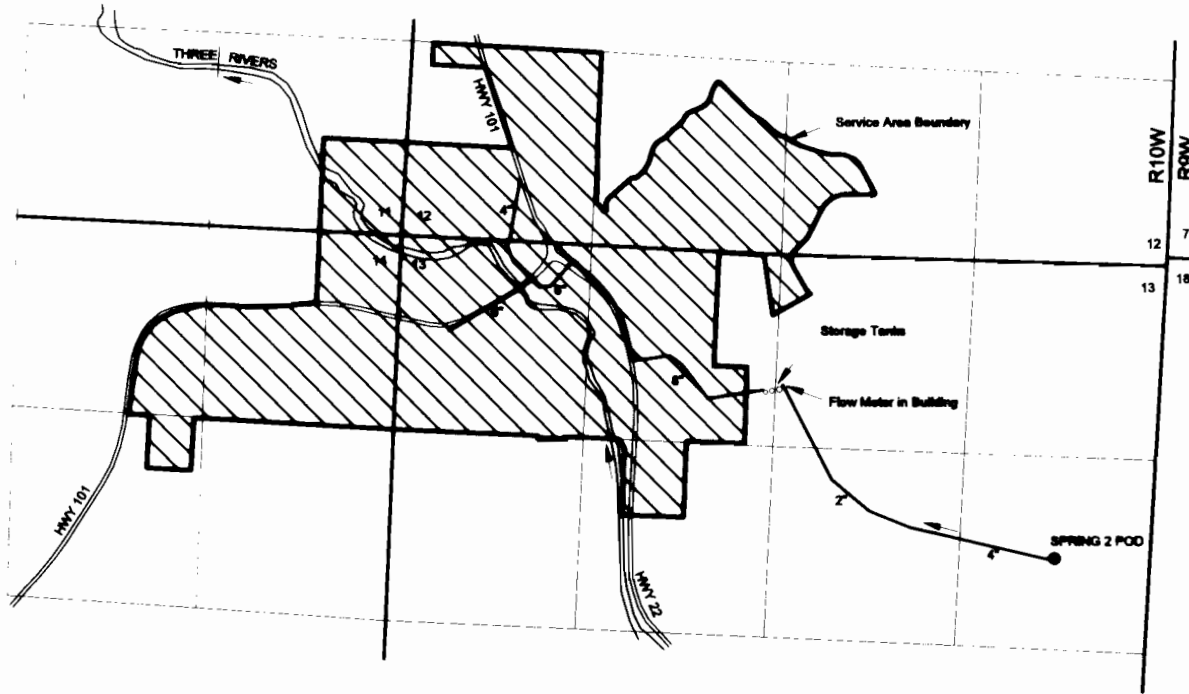

POD is located 2210 ft S and 4475 ft E from NW corner of Section 13, T4S, R10W, WM

**EXPLANATION:**

 - Place of Use

Note: Site inspection conducted May 4, 2010


July 27, 2010

THIS MAP IS NOT INTENDED TO  
PROVIDE LEGAL DIMENSIONS OR  
LOCATIONS OF PROPERTY  
OWNERSHIP LINES.



**SKOOKUM**  
WATER ASSOCIATES NC

P.O. Box 80174  
Portland, OR 97280  
(503) 319-8926

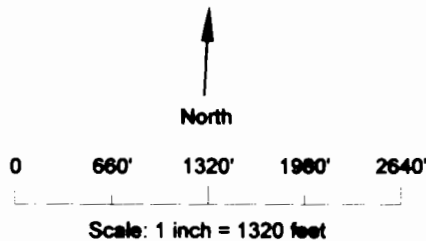

Claim of Beneficial Use Map

Hebo Joint Water and  
Sanitary Authority

Figure 1