
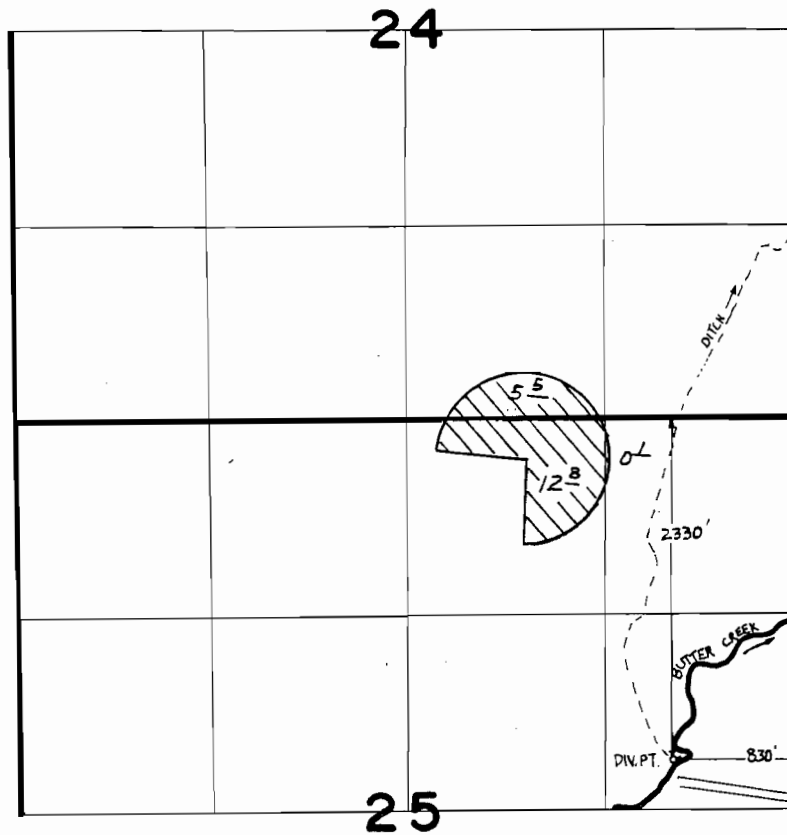


RECEIVED

JUL 6 - 1998

WATER RESOURCES DEPT.
SALEM, OREGON

T. 3 N. R. 27 E. W.M.

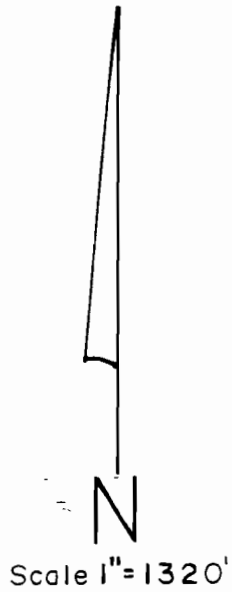

FINAL PROOF SURVEY

UNDER

TRANSFER 585I

IN NAME OF

.....**JOHN FRANK MADISON**.....

Surveyed March 30 1987., by V. Church.....