


**PUMP HOUSE #1**  
 1- 25 H.P. - 1000 G.P.M. TO GREENHOUSE TANKS  
 2- 60 H.P. - 500 G.P.M. EA. DISCHARGE TO  
 2- 50 H.P. - 500 G.P.M. EA. MANIFOLD INTO  
 6- 40 H.P. - 450 G.P.M. EA. 3-8" DIA. MAINS  
 2- 30 H.P. - 550 G.P.M. EA. TO TUBE HOUSE AREA

**PUMP HOUSE #2**  
 1- 75 H.P. - 1200 G.P.M.

- BURIED MAINLINES
- ▨ FIELD PLANTED
- ▩ CONTAINERS
- ▧ GREENHOUSES
- ▤ TUBE HOUSES
- ▥ IRRIGATION ONLY

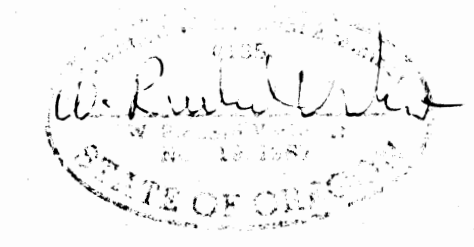

SURVEYED 8.31.95		
OREGON GARDENS PRODUCTS GALES CREEK NURSERY		
SCALE: 1"=400'	APPROVED BY: WRV 11-18-95	DRAWN BY: J.B.R.
DATE: 10-21-95		REVISED
FINAL PROOF SURVEY	UNDER APPLICATIONS 70124, R-70718	PERMITS 51132, R-11262
W. RICHARD VERBOORT, C.W.R.E. 466 SE 30th AVE. HILLSBORO, OR 97123		DRAWING NUMBER 95-D-06