

RECEIVED

APR 07 1994

WATER RESOURCES
SALEM, OREGON

WATER RIGHT TRANSFER MAP


T26S, R4W, WM

SCALE 1" = 1320'

T6955


DOUGLAS COUNTY


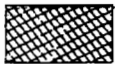
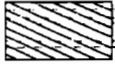
NORTH BANK COUNTY RD NO 200

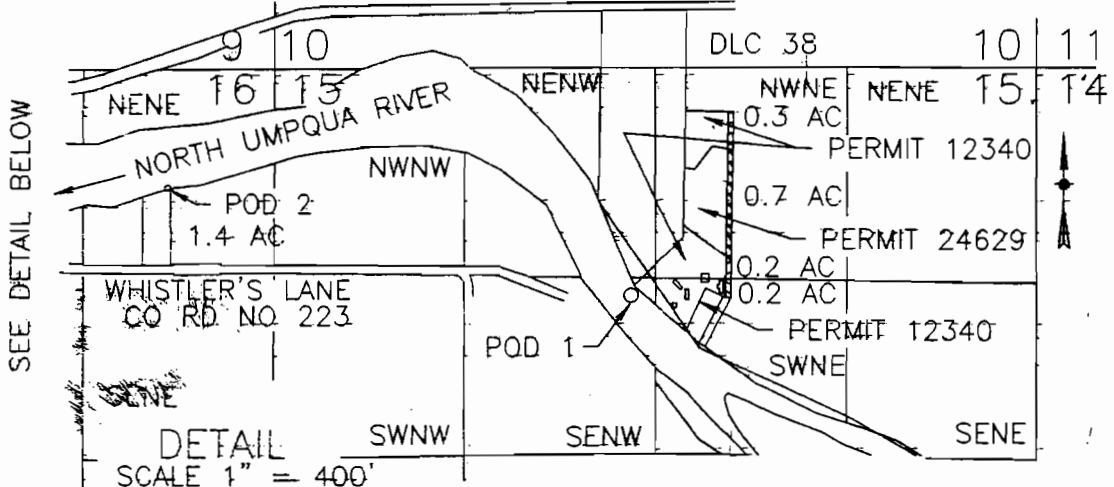

SEE DETAIL BELOW

DETAIL
SCALE 1" = 400'

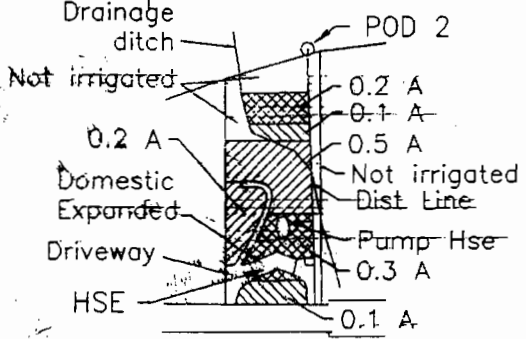

-  PERMIT NO 24629, DECEMBER 17, 1956
-  PRIMARY PERMIT NO 51442, FEB 18, 1992
SUPPL PERMIT NO 12340, AUG 31, 1936
-  PERMIT NO 12340, AUGUST 31, 1936

TRANSFER OF WATER RIGHT FROM NWNE AND SWNE SEC 15 TO NENE SEC 16.

POD 1 IS 1550 FT S AND 2760 FT W FROM NE COR SEC 15
POD 2 IS 520 FT N AND 580 FT E FROM SW COR, NE 1/4 NE 1/4, SEC 16

FINAL PROOF SURVEY UNDER

Application No. T-6955

IN NAME OF

WILLIAM OR SHIRLEY BUCKINGHAM

OWNERS
WILLIAM OR SHIRLEY BUCKINGHAM
1250 WHISTLERS LANE
ROSEBURG, OR 97470

CWRE
MAURICE E FARR
395 NE KIRBY AVENUE
ROSEBURG, OR 97470

Surveyed July 20, 1994 by M E Farr

THIS IS A LOCATION MAP FOR A WATER RIGHT TRANSFER BY WILLIAM OR SHIRLEY BUCKINGHAM. THIS MAP IS FOR THE PURPOSE OF IDENTIFYING THE LOCATION OF THE WATER ONLY AND IS NOT INTENDED TO PROVIDE LEGAL DIMENSIONS OR LOCATIONS OF PROPERTY OWNERSHIP LINES.

Certified Water Right Examiner
#046 WRE
Maurice E. Farr
Maurice E. Farr
Nov. 19, 1987
STATE OF OREGON
EXPIRES 12-31-05