


TOWNSHIP 13 SOUTH, RANGE 5 WEST, W.M.

NOV 12 2010

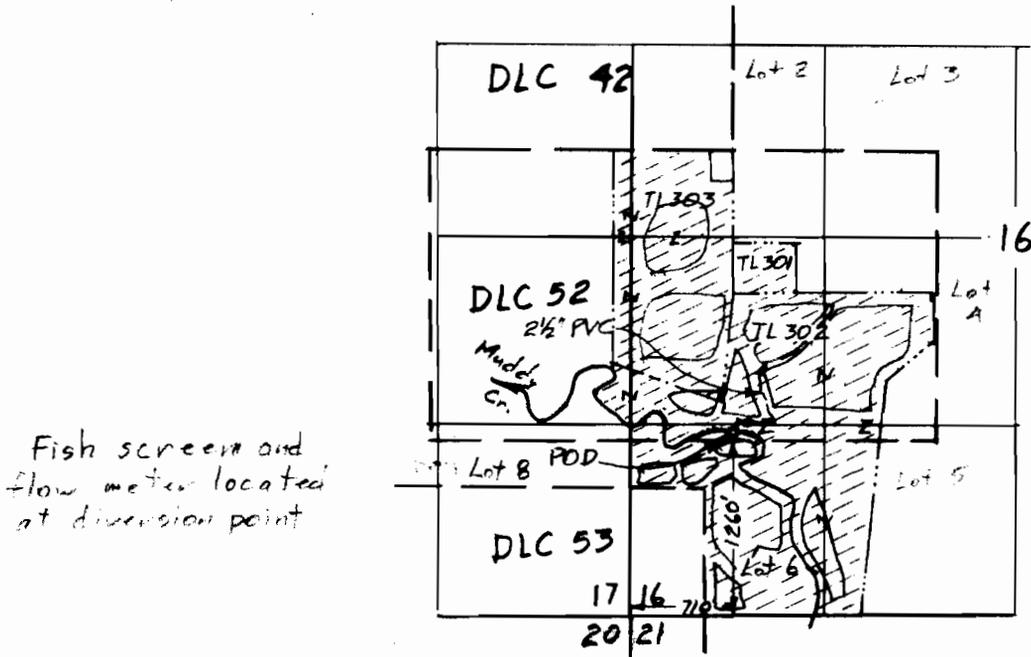

Scale 1" = 1320'
(4" = 1 mile)


Surveyed June 30, 2009

⊕ Wildlife Use Area
(Attraction Ponds & Crops)

T-10173

Claim of Beneficial Use Map for

Don & Suzan Hamblin

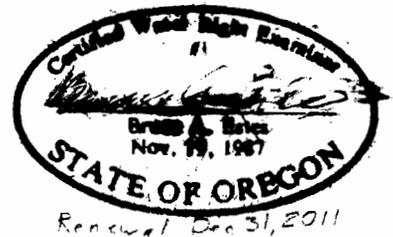

This map is for the purpose of locating a water right only and has no intent to provide legal dimensions or the location of property lines.

ESTES SURVEYS, LLC
PO Box 17619 60352 Arnold Rd
Selem, OR 97705-7619 Bend, OR 97702
(503) 566-7583 (541) 382-7391

Amended Nov 3, 2010