

RECEIVED
SEP 03 1987

This drawing is a Final Proof Survey for a Ground Water Right. It is not a Land Survey. Property lines and/or other lines of occupation shown hereon are not represented by the undersigned to meet accuracy standards of Land Surveys.




SALEM, OREGON

SCALE: 1" = 400'


**SECTIONS 30 & 31, T.1S., R.4E., W.M.
CLACKAMAS COUNTY, OREGON**

Application No. **G-13272**

Permit No. **G-11611**

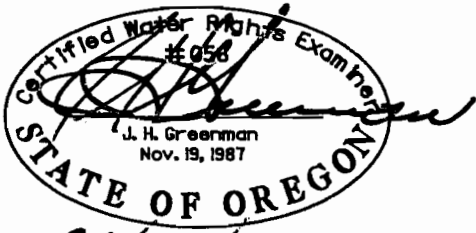

96/08/23

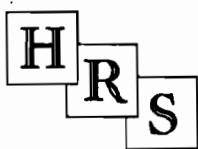

**HANER, ROSS &
SPORSEEN, INC.**
15 S.E. 82ND DRIVE
GLADSTONE, OREGON 97027

REARDON NURSERY INC.
**GROUND WATER RIGHT
FINAL PROOF SURVEY**

630DD

File C:\unth\dgn\930dd_1.dgn edr 8/23/96