


RECEIVED

SEP 23 1997

WATER RESOURCES DEPT  
SALEM, OREGON

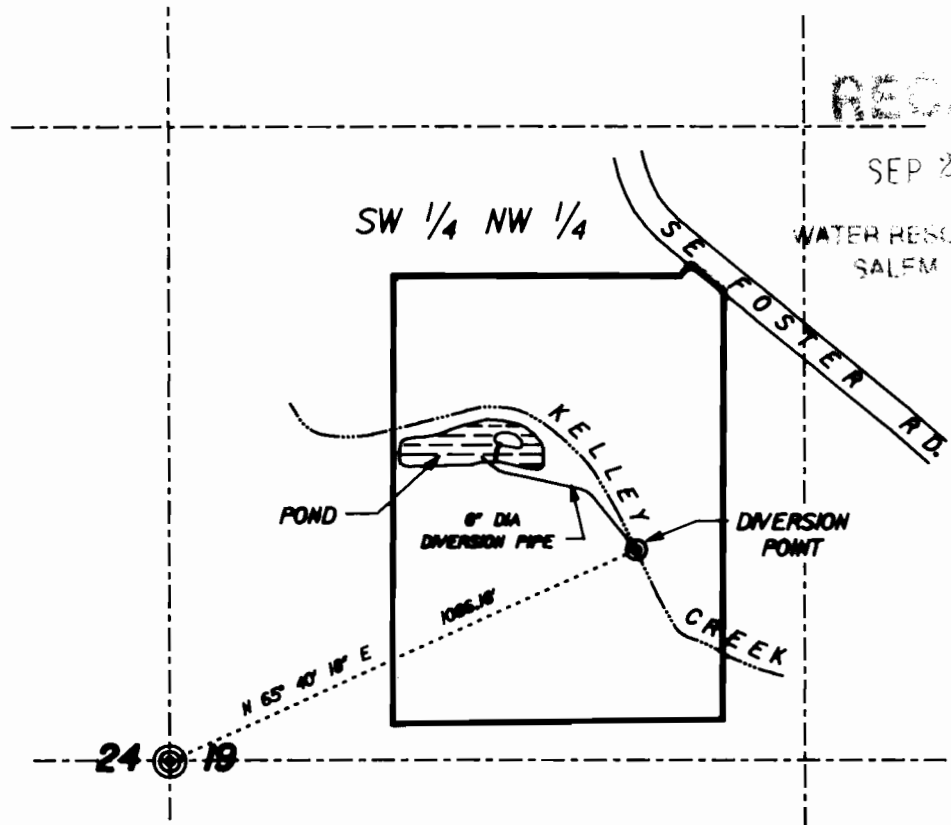

This drawing is an exhibit for a Final Proof Survey. It is not a Land Survey. Property lines and/or other lines of occupation shown hereon are not represented by the undersigned to meet accuracy standards of Land Surveys.



SCALE: 1" = 400'


**SECTION 19, T.1S., R.3E., W.M.  
MULTNOMAH COUNTY, OREGON**



9/29/17

Application No. S-73800

Permit No. S-52712

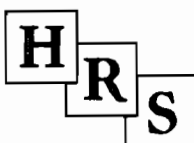

**HANER, ROSS &  
SPORSEEN, INC.**

15 S.E. 82ND DRIVE  
GLADSTONE, OREGON 97027

**A.J. OBRIST  
FINAL PROOF SURVEY**