



T. 9S., R. 15E., W.M.

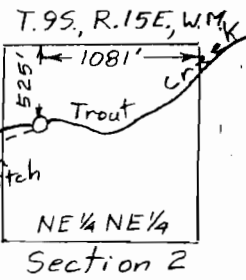

POD #1
100' N & 300' E
from W 1/4 corner
of Section 3

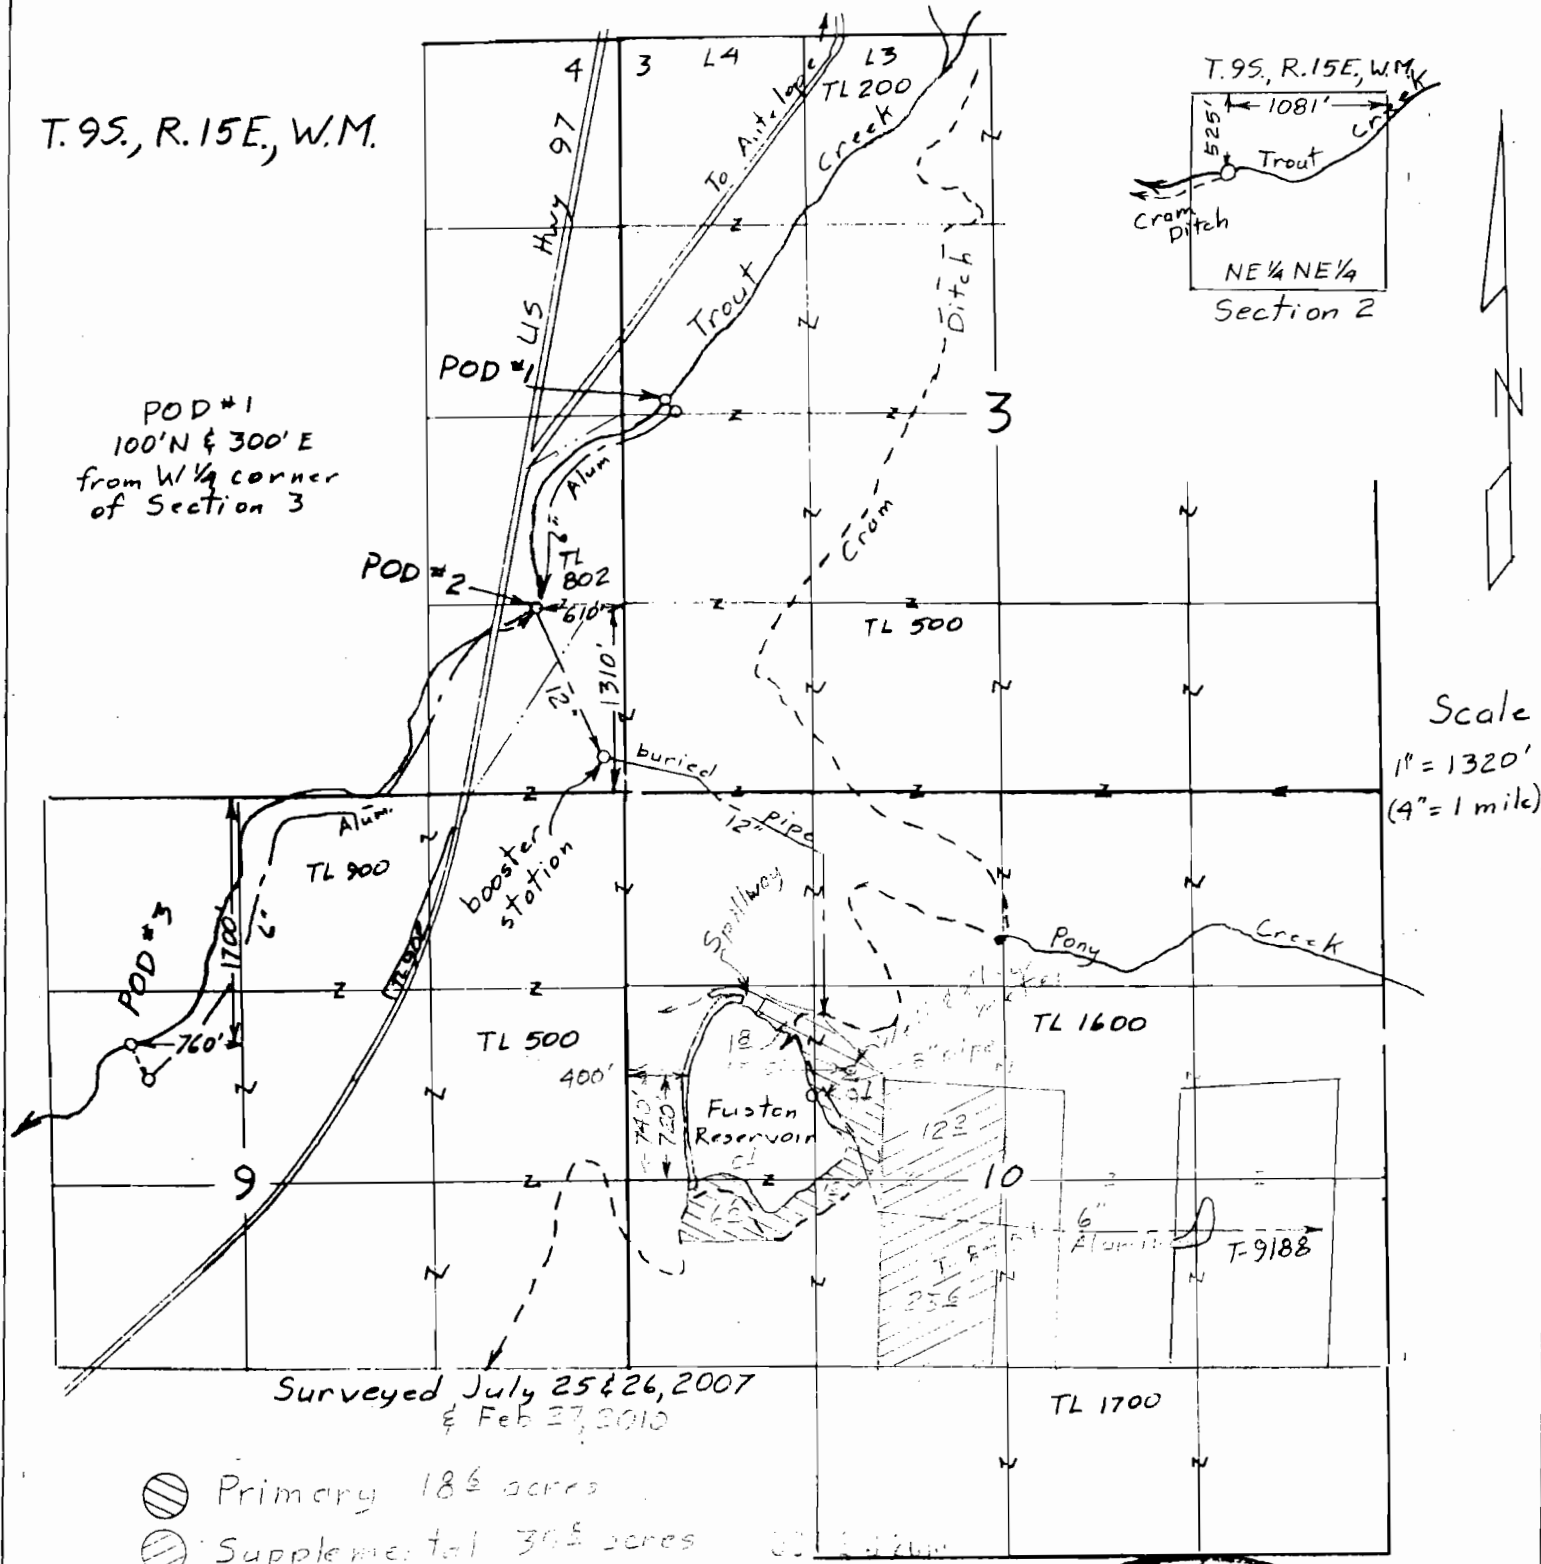

Scale
1" = 1320'
(4" = 1 mile)


Surveyed July 25 & 26, 2007
& Feb 27, 2010

- ⊙ Primary 18 1/2 acres
- ⊙ Supplemental 30 1/2 acres

App G-15105
Per G-13875

Claim of Beneficial Use Map for Columbia Empire Farms, Inc. (R-2 Ranch)

This map is for the purpose of
locating a water right only
and has no intent to provide
legal dimensions or the location
of property lines.

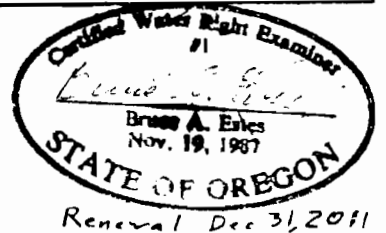

ESTES SURVEYS, LLC
 PO Box 47610 80382 Arnold Rd
 Salem, OR 97306-7610 Bend, OR 97702
 (503) 586-7599 (541) 382-7391