

MAP
OF
BOSSHARDT WATER SYSTEM
IN

N.E. 1/4 of N.W. 1/4 SEC. 5 T.1 S. R.4 E. & S.E. 1/4 of S.W. 1/4 SEC. 32 T.1 N. R.4 E. W.M.

MULTNOMAH COUNTY OREGON

SCALE 1" = 200'

BANNER ACRES


62

63

64

65

S.E. 1/4 of S.W. 1/4

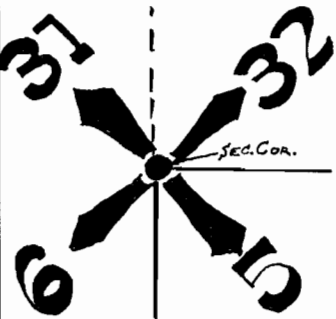

T.1 N. R.4 E. W.M.
T.1 S. R.4 E. W.M.

1 ACRE
STORAGE
TANK

HOME

450 FT. DIAMETER

PIPE

100 FT.

RAM

6.76 IN. 330.0 FT.

SPRING

320.0 FT.

BOX INTAKE

80 FT. DRIVE PIPE

RAM

COLUMBIA RIVER HIGHWAY

NIELSON

N.E. 1/4 of N.W. 1/4

12906

9181

I, O.G. PORTER OF PORTLAND, OREGON DO HEREBY CERTIFY
THAT, THIS MAP WAS MADE FROM NOTES TAKEN DURING AN ACTUAL
SURVEY MADE BY ME IN JULY 1929, AND THAT IT COR-
RECTLY REPRESENTS THE WORK DESCRIBED IN THE AC-
COMPANYING APPLICATION, TOGETHER WITH THE LOCATION OF
STREAMS AND PITCHES IN THE IMMEDIATE VICINITY.

O.G. Porter

REGISTERED PROFESSIONAL ENGINEER

OREGON, No. 472

Nov. 25 1919

(DATE OF REGISTRATION)

RIVER

SANDY