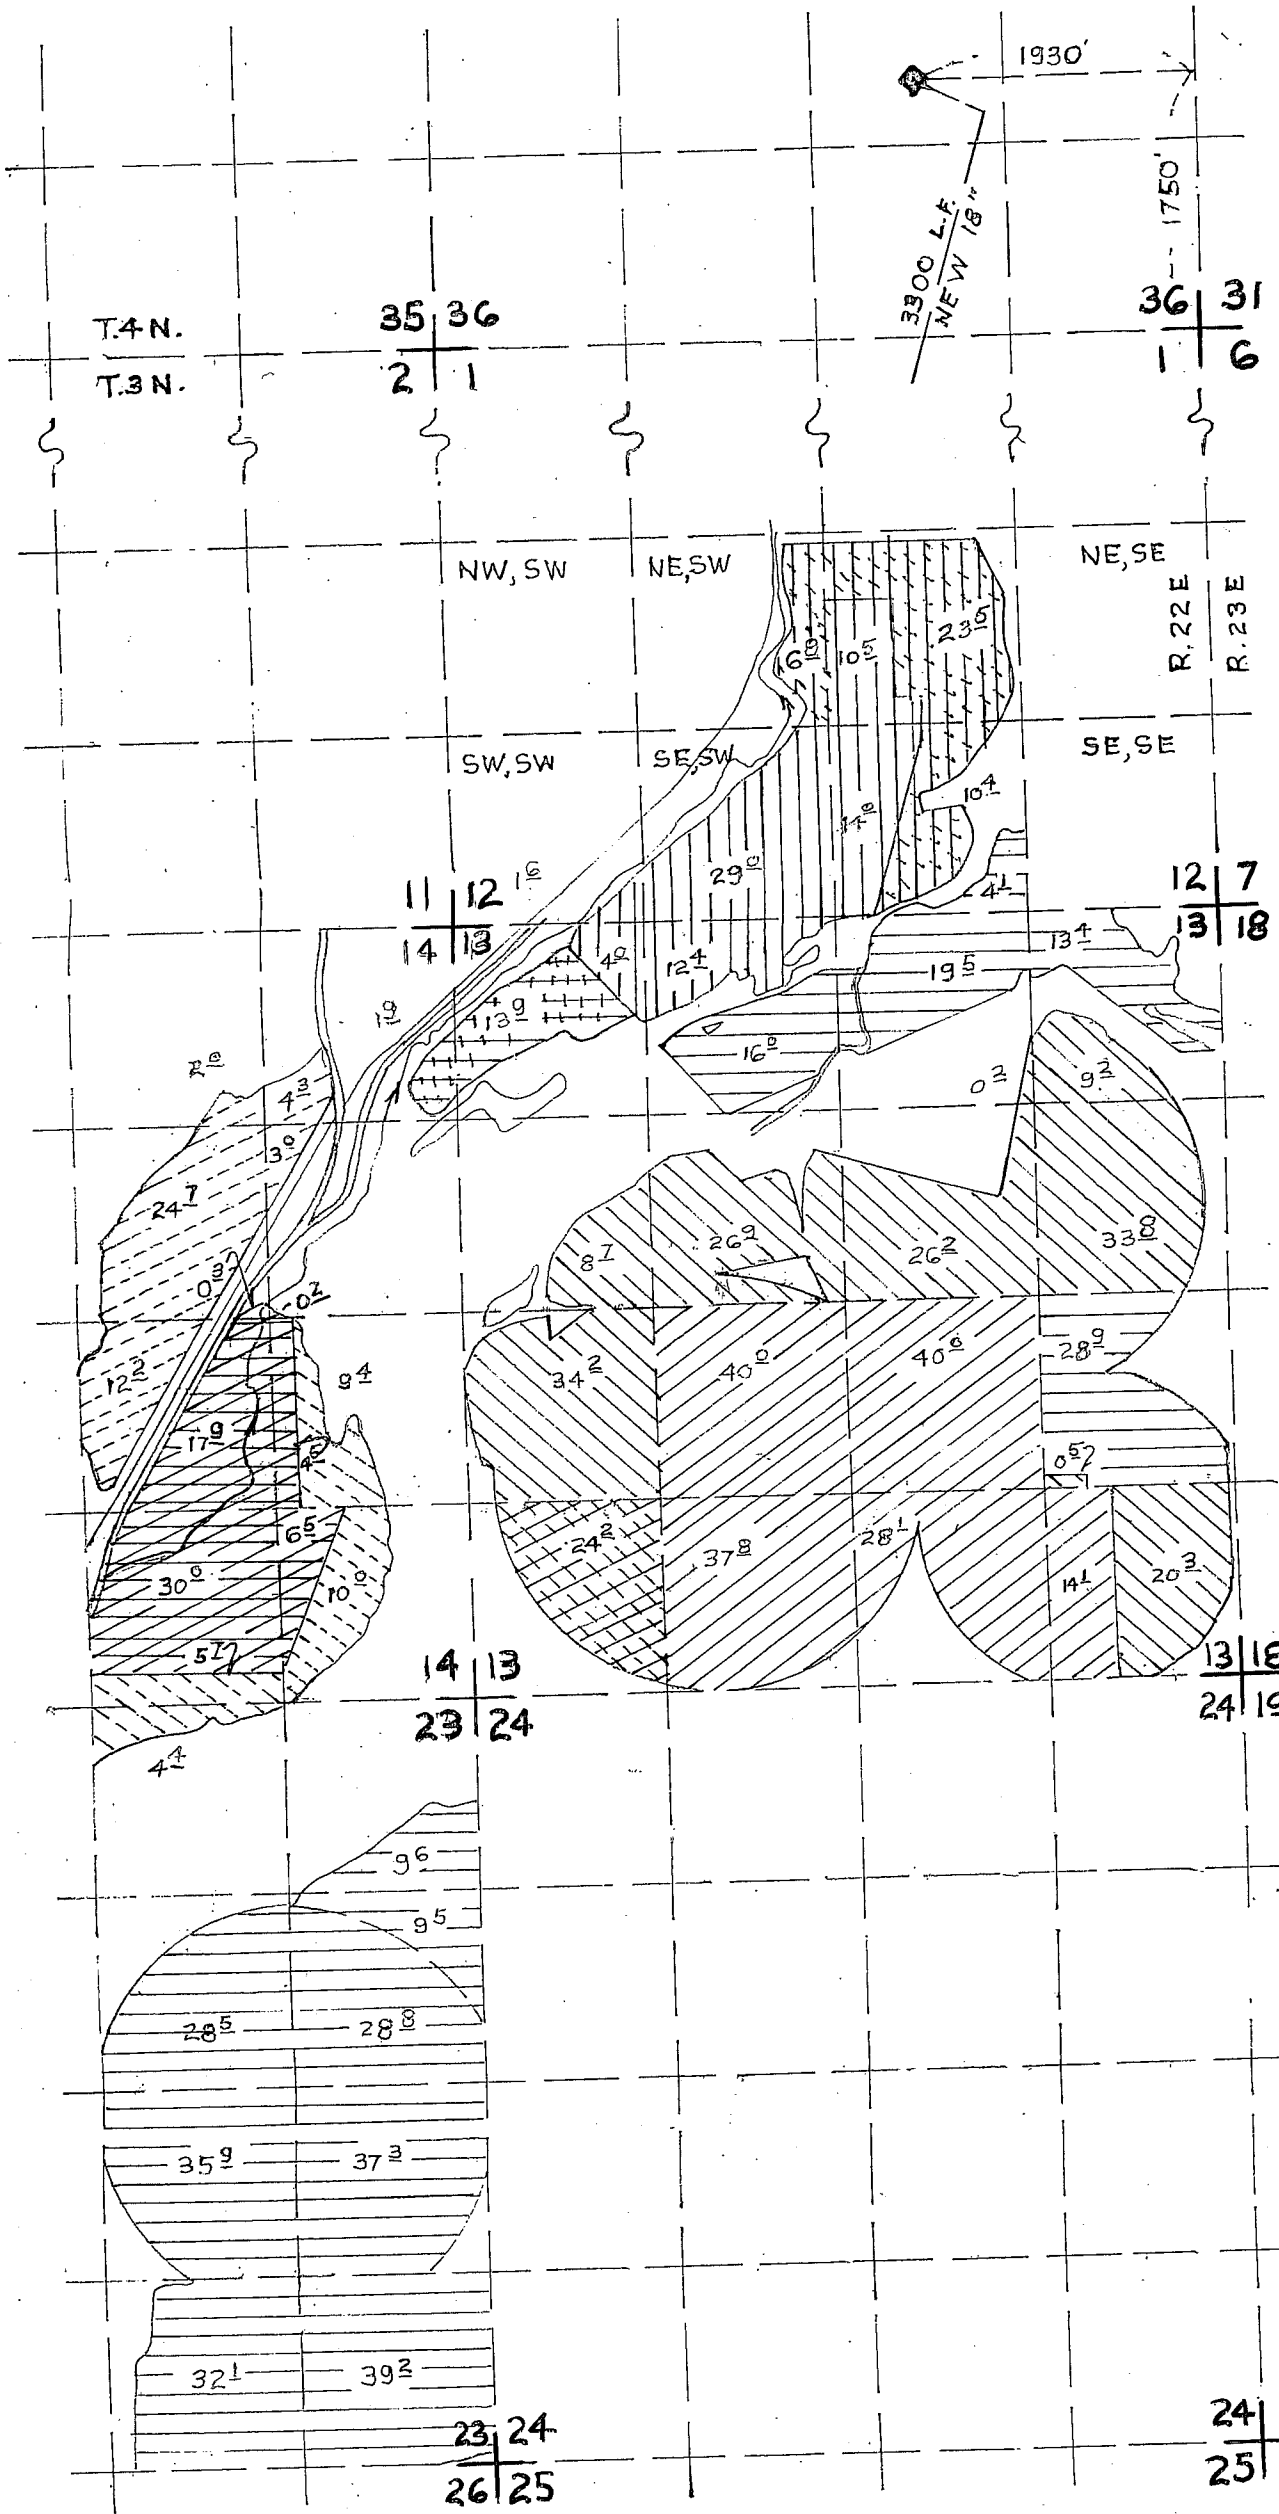

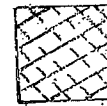



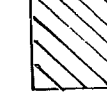


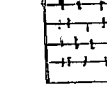



ADDITIONAL POINT OF DIVERSION

RECEIVED
 MAR 01 1995
 WATER RESOURCES DEPT.
 SALEM, OREGON



-  35002 DAVIS PRIMARY
-  35002 SULLIVAN PRIMARY
-  35002 DAVIS SUPPL.
-  35002 SCHRIMSHER SUPP.
-  35003 SULLIVAN PRIMARY
-  35004 SULLIVAN PRIMARY
-  35005 CRISP PRIMARY
-  35005 CRISP SUPPL.
-  35005 SULLIVAN SUPPL.
-  38225 CRISP

KRUMBEIN ENGINEERING LTD.
 ENGINEERS - SURVEYORS - PLANNERS
 361 S.E. Second Pendleton, Oregon

Scale 1"=1320'	Drn. By DHK	Drng. No. 9501B	Revision 1
Date 2-23-95	Ckd. By	Job No. 91-4	Revision 2

FINAL PROOF MAP
BRIAN SULLIVAN
T-6496

SEC. 36, T. 4N., R. 22 E.W.M
 SECS. 12,13,14,23 T.3N., R.23 E.



RENEWS 6/30/95