


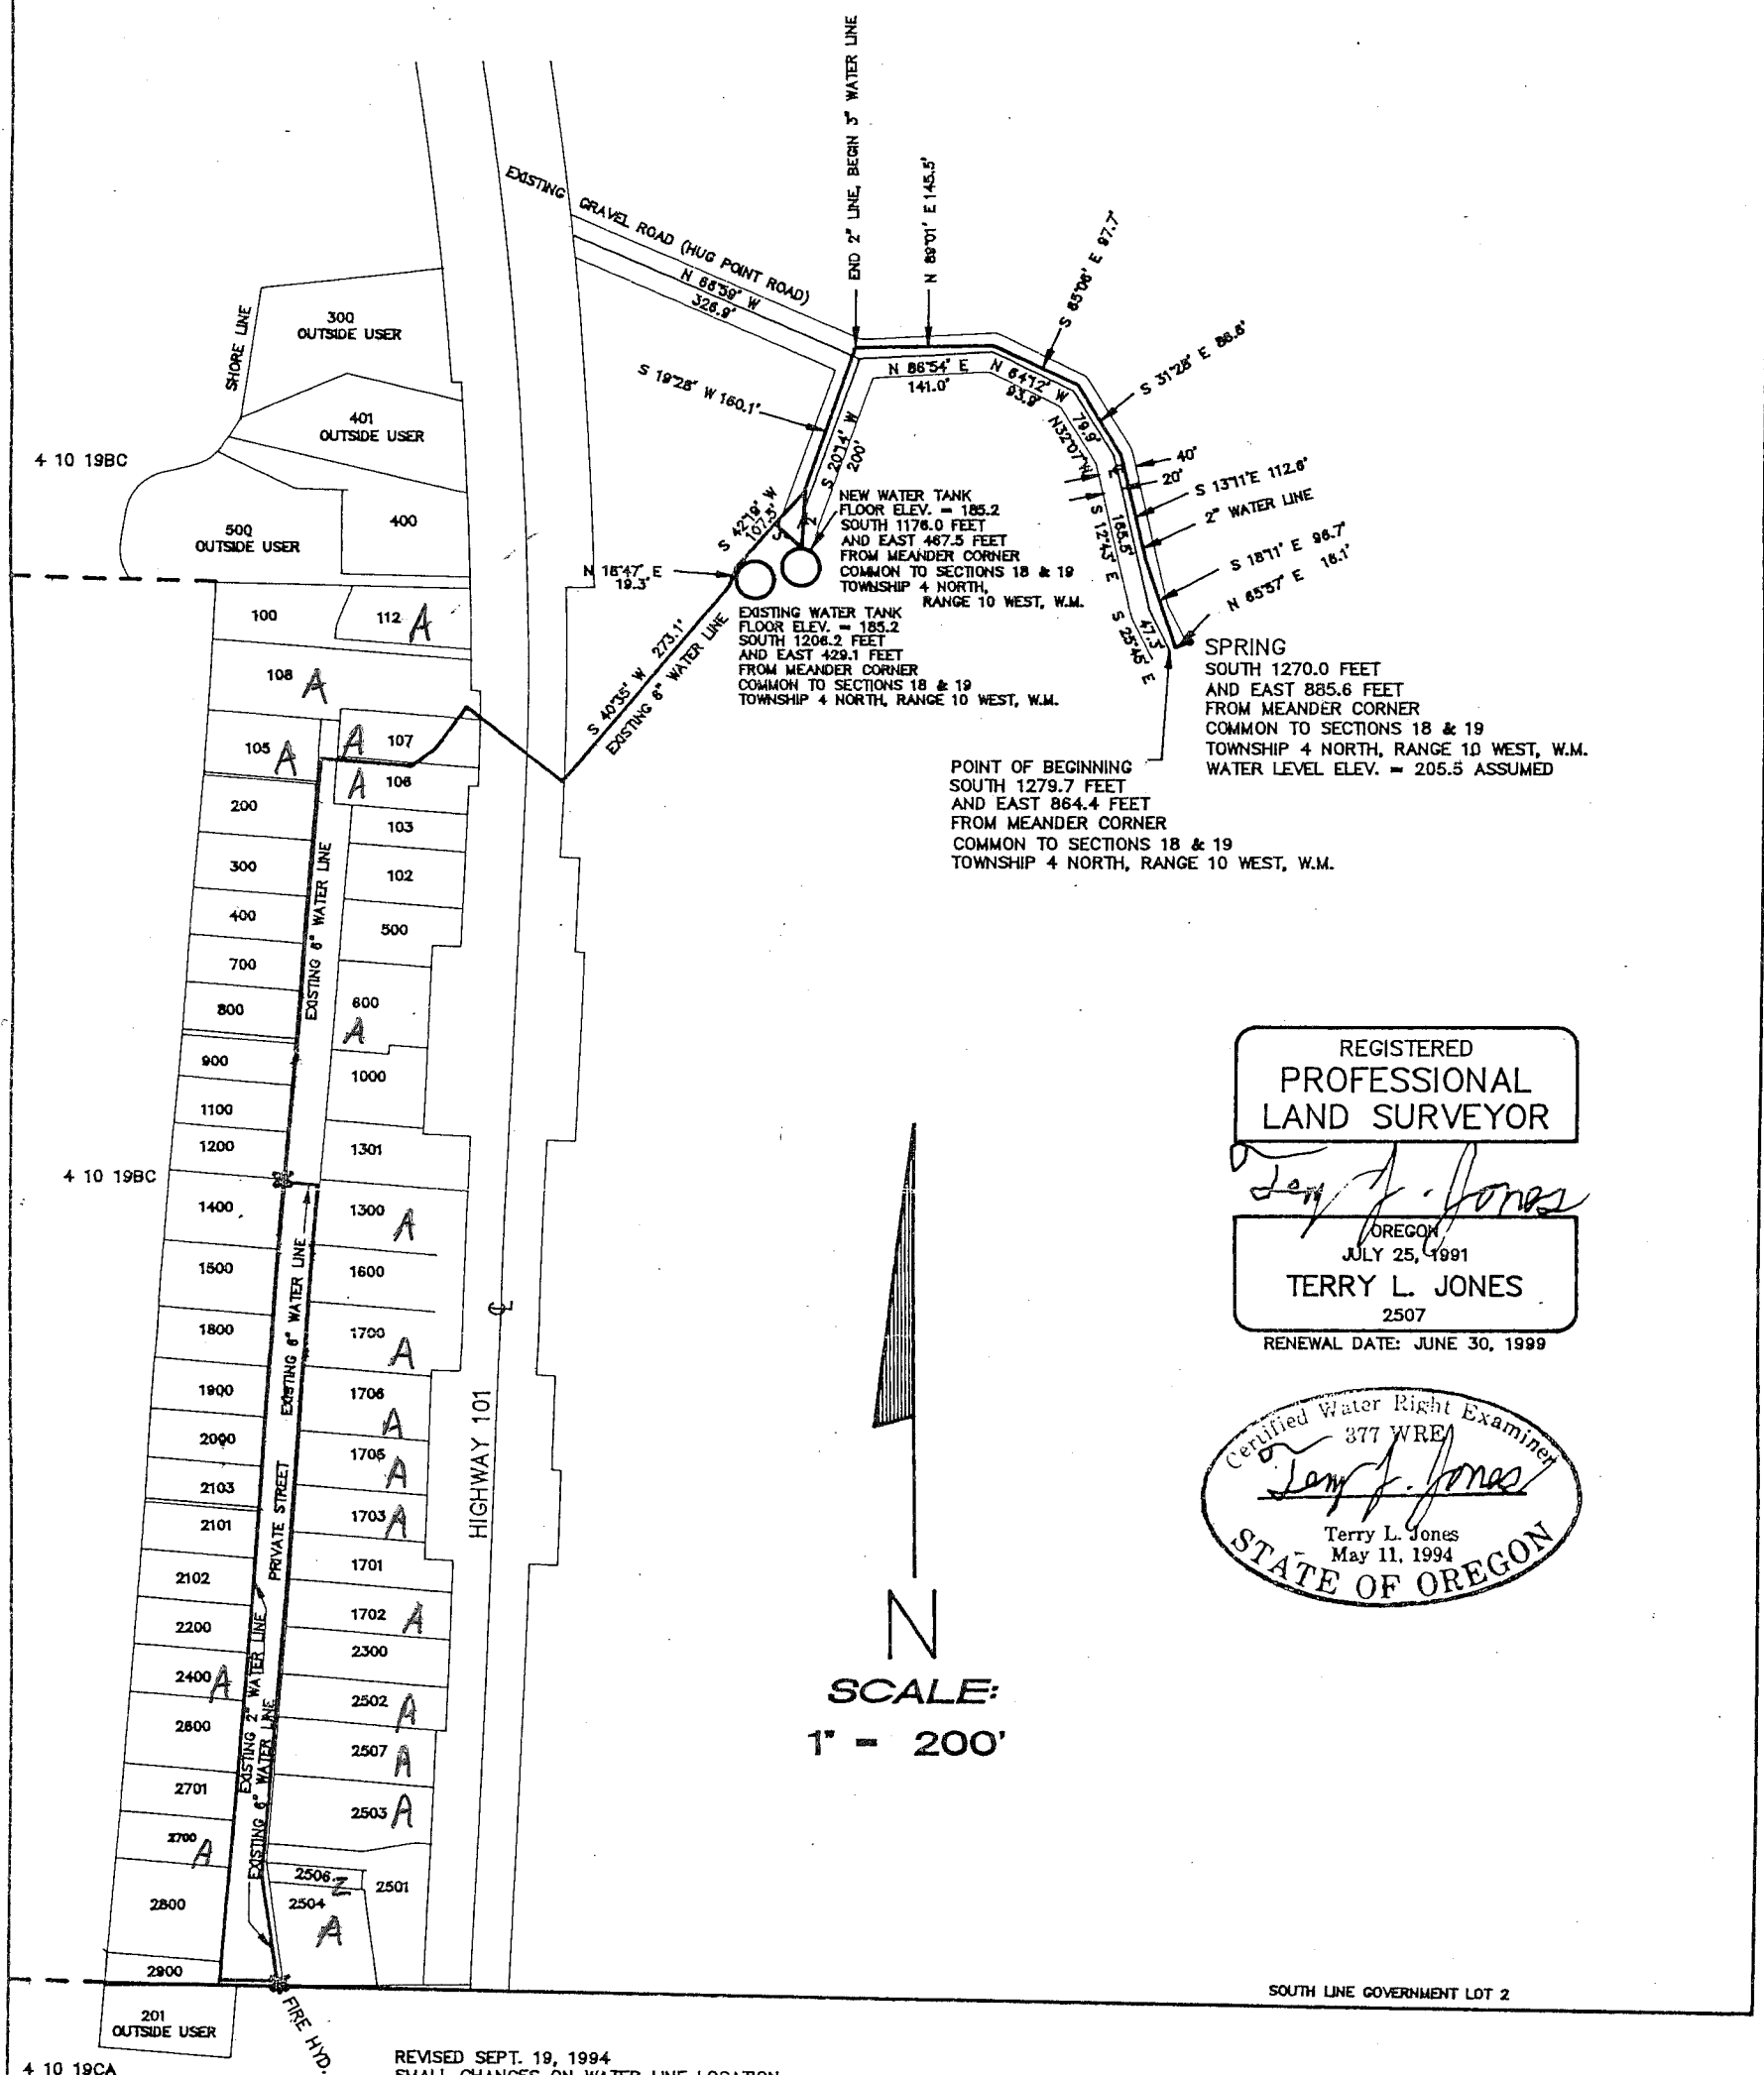

REGISTERED
PROFESSIONAL
LAND SURVEYOR
Terry L. Jones
OREGON
JULY 25, 1991
TERRY L. JONES
2507
RENEWAL DATE: JUNE 30, 1999

Certified Water Right Examiner
377 WRE
Terry L. Jones
Terry L. Jones
May 11, 1994
STATE OF OREGON

N
SCALE:
1" = 200'

4 10 19BC
4 10 19CA

FINAL PROOF SURVEY FOR
APPLICATION FILE No. 73068
PERMIT No. 51550

SITE\CVPWD-SV.DWG
CVPWD.CR5

SURVEY BY:
BAYSIDE SURVEYING
11765 HWY 101 SOUTH
TILLAMOOK, OR. 97141
(503) 842-5551

SURVEY FOR:
CANNON VIEW PARK
WATER DISTRICT
SECTION 19, T4N, R10W, W.M.
CLATSOP COUNTY, OR

DATE	EQUIPMENT	FIELD	DRAWN	CHECKED	JOB NO.
SEPT. 29, 1998	TOPCON GTS-303 TDS 480	TLJ/CJH	CJH	TLJ	

RECEIVED
OCT 07 1998
WATER RESOURCES DEPT.
SALEM OREGON