

RECEIVED

MAR 10 1997

T. 38 S., R. 1 W., W.M.
(TRANSFER POINT OF DIVERSION)

DLC 64

WATER RESOURCES DEPT.
SALEM, OREGON

SW 1/4 - NW 1/4

DLC 65

SE 1/4 - NW 1/4

5/8" REBAR

389°55'W 1331.46'

RAPP ROAD

1852 PRIORITY 42 1852 PRIORITY

26

DLC 63

NW 1/4 - SW 1/4

5/8" REBAR
P.O.B. 15 NORTH
1855.53' & EAST
1.35' FROM
S.E. COR. DLC 63

N 18°59'35" E
464.17'

TRANSFERRED POINT
OF DIVERSION IS
1785' NORTH &
985' WEST OF 1/4 COR.
SEC'S 26 & 35

INLET WAGNER-
THORNTON DITCH
(NOW OBLITERATED)
IS N 42°18'W, 1990'
FROM SOUTH 1/4
COR. SEC. 26 (BY
1911 SURVEY MAP)

/// - AREA IN PEACH
ORCHARD IRRIGATED
OUT OF OLD WATER
RIGHTS CERTIFICATE
50371

SW 1/4 - SW 1/4

01 1854 PRIORITY
02 1854 PRIORITY

WAGNER CREEK

70
1854
PRIORITY

N 41°25'55" E
150.60'

N 28°44' E
226.00'

NE 1/4 - SW 1/4

SE 1/4 - SW 1/4

FINAL PROOF MAP

APPLICANT: HARRY and DAVID, an
OREGON CORPORATION
P. O. BOX 9000
MEDFORD, OREGON 97501


SCALE: 1" = 400'

WATER RIGHT TRANSFER NO. 7336

FD. 3/4" IRON PIPE
SE COR. DLC 63

DLC 66

NOTE: ROCKFELLOW DITCH INLET
FROM WAGNER CREEK IS
884' SOUTH & 268' WEST
FROM S.E. COR. DLC 63

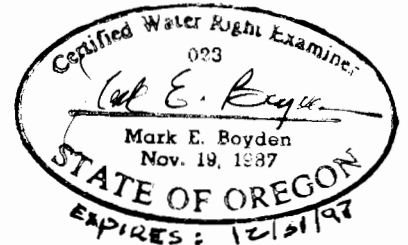

1/4 COR. SEC'S. 26 & 35

NOTE: 3.6 ACRES IN
NE 1/4 - SW 1/4
WERE RETAINED
BY CHESTER RAPP