

T 16 S, R 3 E, W.M.

THE PURPOSE OF THIS MAP IS TO IDENTIFY THE LOCATION OF THE WATER RIGHTS. IT IS NOT INTENDED TO PROVIDE INFORMATION RELATIVE TO THE LOCATION OF PROPERTY OWNERSHIP BOUNDARY LINES.



SCALE: 1" = 400'


30 | 29

31 | 32

RECEIVED

NOV 17 1999

**WATER RESOURCES DEPT.
SALEM, OREGON**

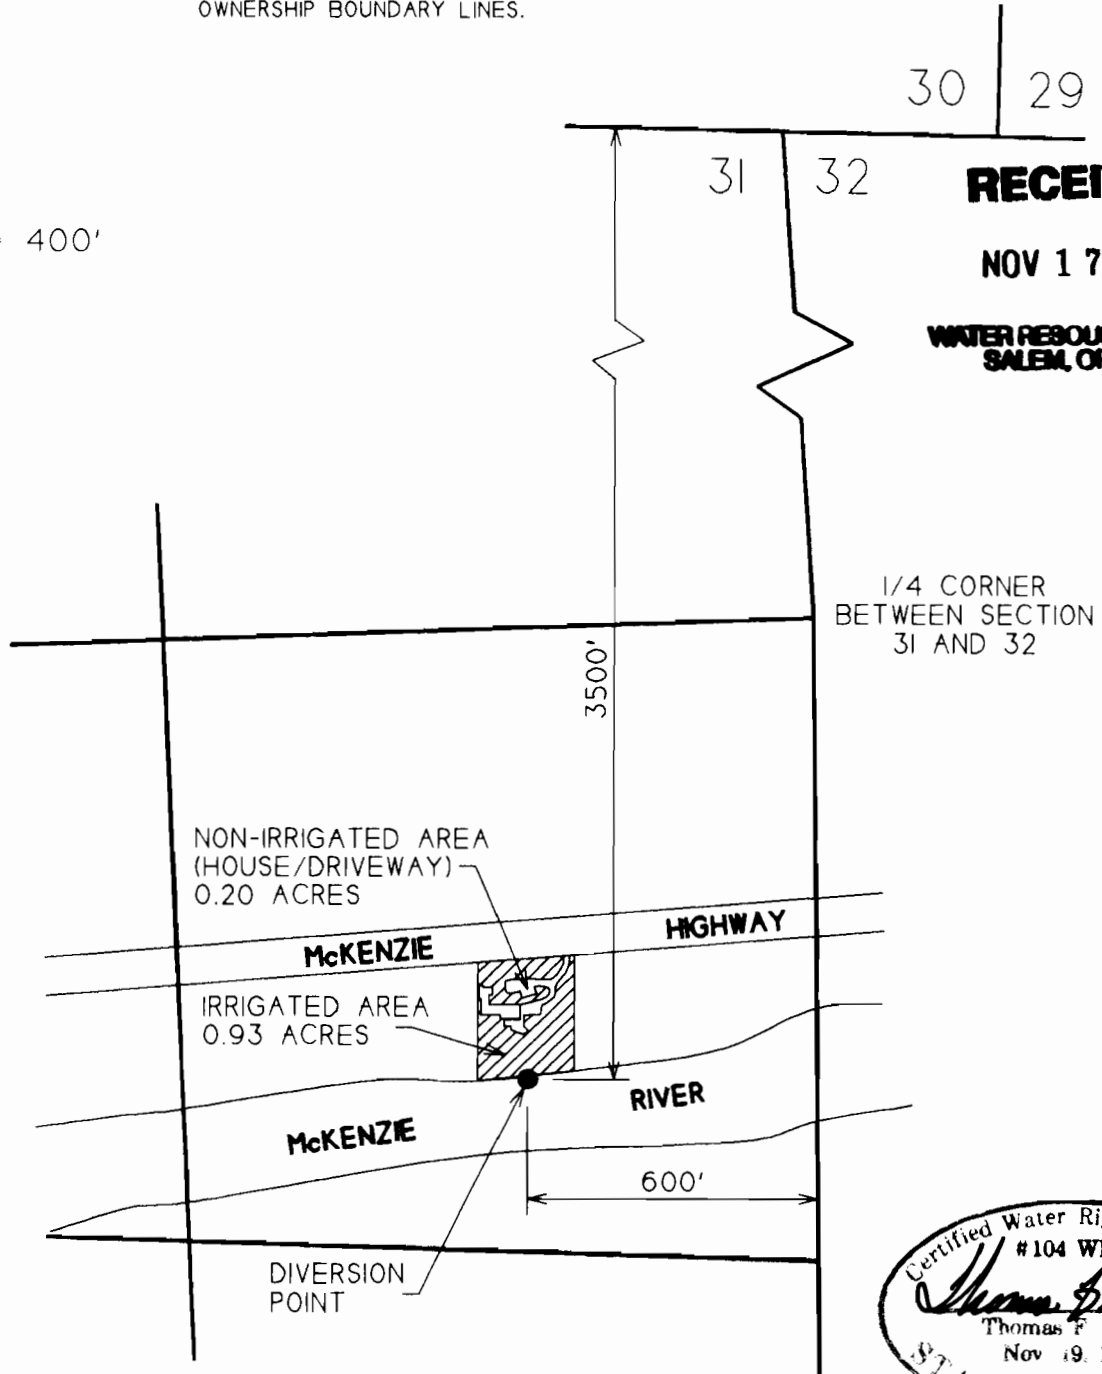

**FINAL PROOF SURVEY
UNDER**

APPLICATION NO. S-83636 PERMIT NO. 53543

IN THE NAME OF

DOUGLAS E. WALWYN

CADD FILE: 2669PROF.GCD COGO FILE: 2669

DRAWN: 10/5/99 DPS
LAST REVISED: 11/3/99 DPS