

SEC. 14 RES. #1 (EXISTING)

UPPER CRANE CRK. RANCH

R-87466



WATER RESOURCES DEPT.
SALEM, OREGON
SEP 14 2010

RECEIVED

RECEIVED

SEP 08 2010
WATER RESOURCES DEPT
SALEM, OREGON

PROPERTY LINE


TAX LOT 100
TSP 25S R34E SEC 14-
HARNEY COUNTY, OR.
NOTE: LOCATION: 2270' E &
580' S OF NW CORN
SEC. 14

SCALE: 1" = 1320'

DATE: 3-28-09

BY: TOM FENL

ADD NO. 6 87466 87466 87466 87466

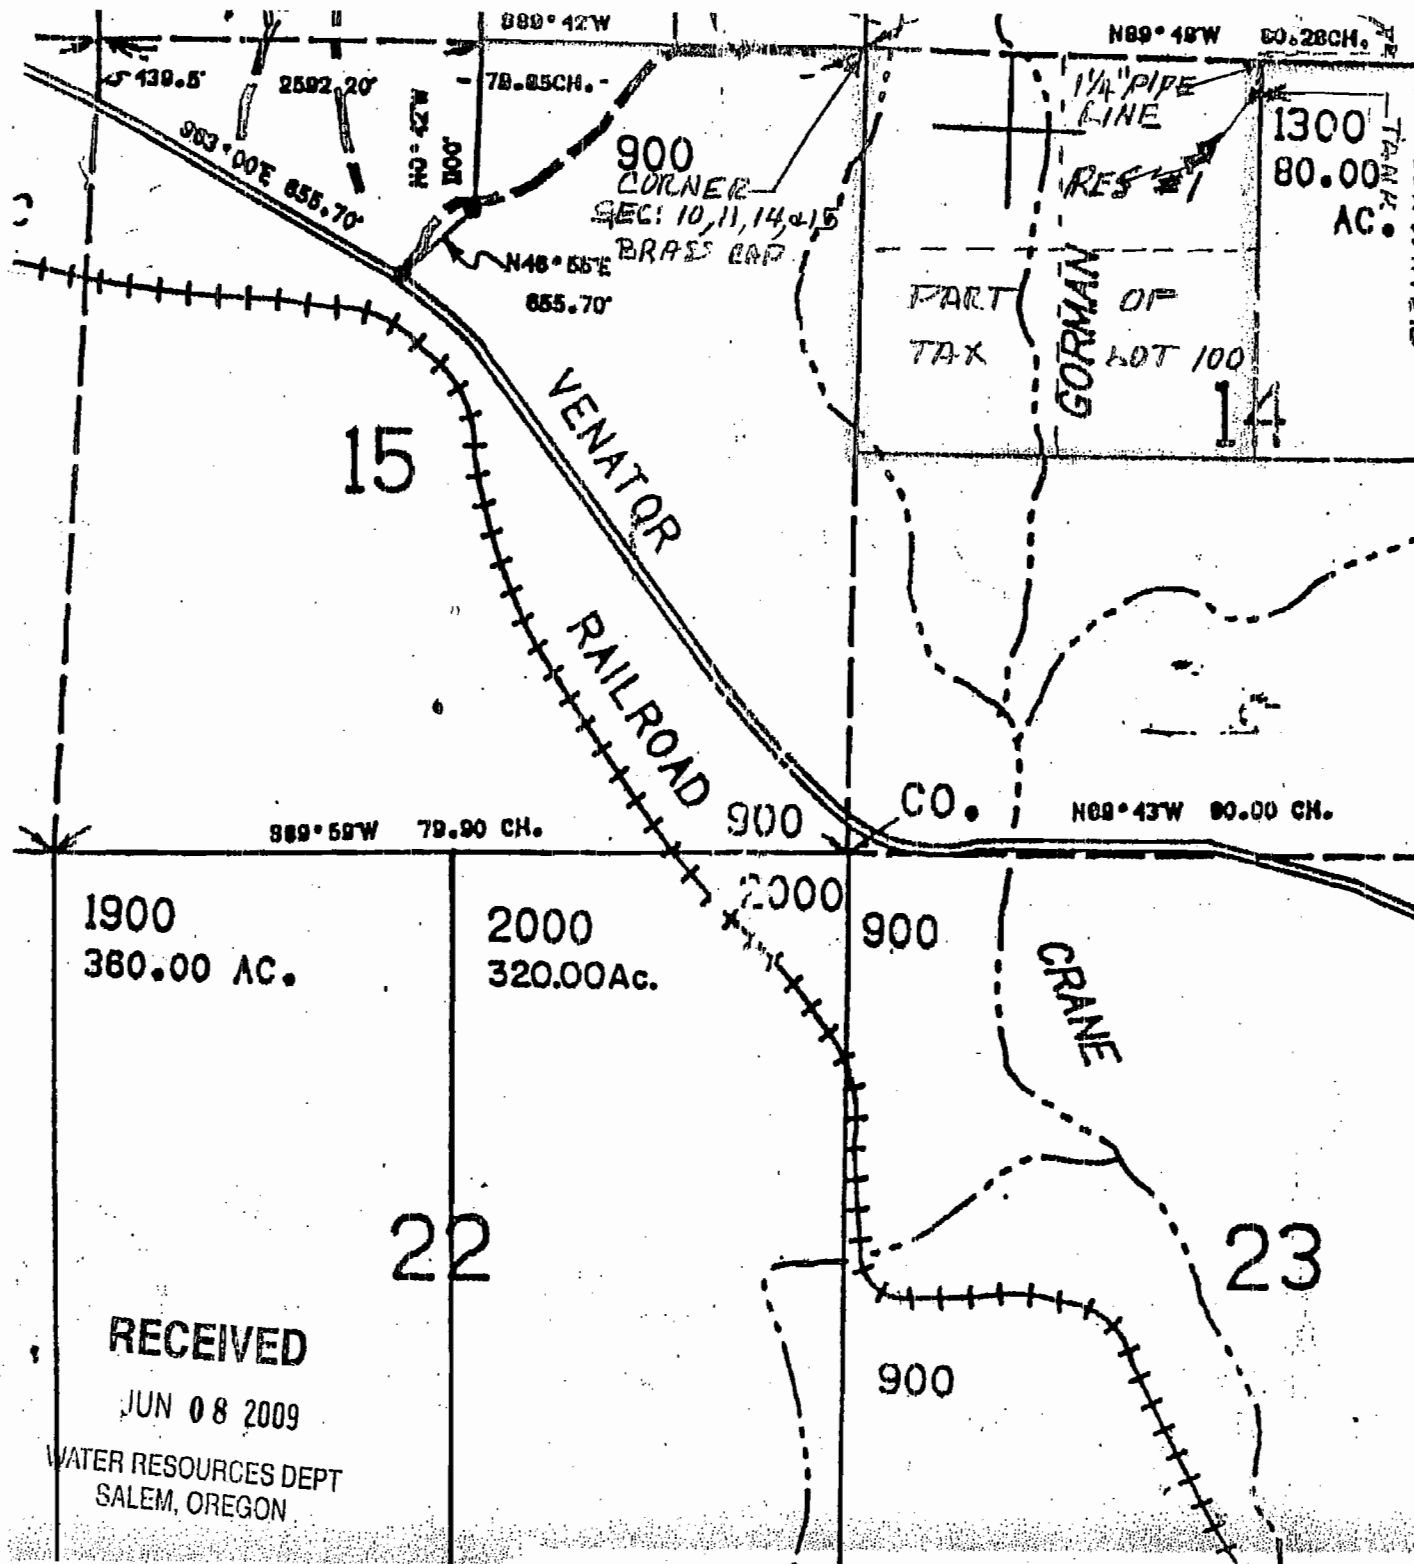

RECEIVED

JUN 08 2009

WATER RESOURCES DEPT
SALEM, OREGON