




TOWNSHIP 15 & 16 SOUTH, RANGE 5 WEST, W.M.

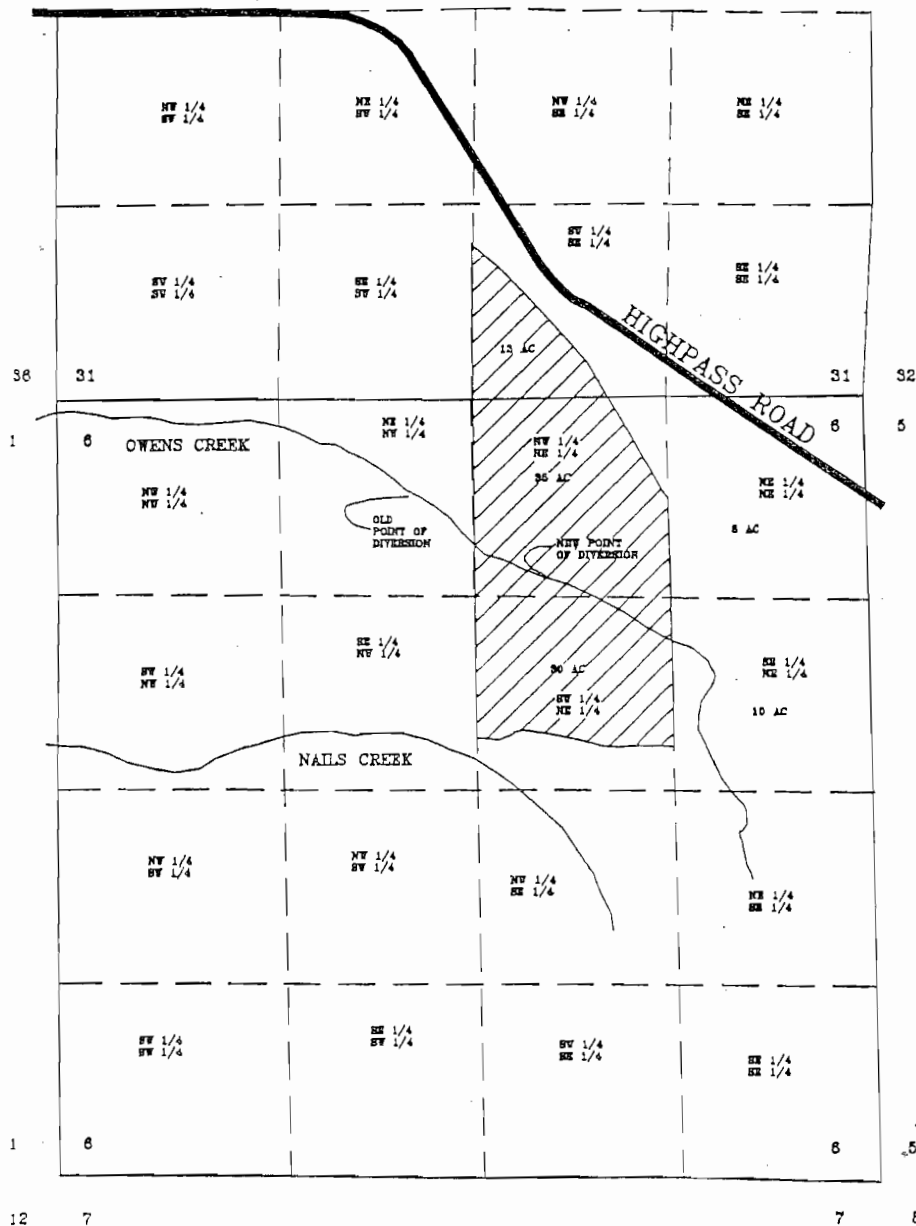

POINT OF DIVERSION LOCATION:
SOUTH 1259.05 FEET & 2164.07
FEET WEST OF THE N.E. COR.
OF SECTION 6.

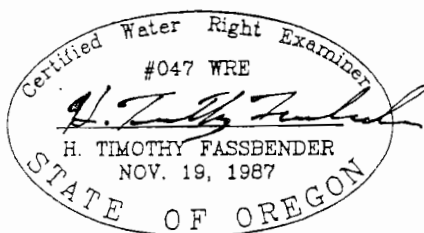

T-6910.AS
FINAL PROOF SURVEY MAP
FOR
MARTHA BRONSON
25621 HIGHPASS ROAD
JUNCTION CITY, OR 97448
PH(503) 998-6072
BY
FORD-NESS-FASSBENDER
PO BOX 22735
EUGENE, OR 97402
PH(541) 344-1852
MAY 2, 1997

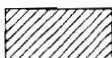

AREA OF BENEFICIAL USE PER T-6910.AS

NOTE:
THIS MAP WAS PREPARED FOR THE
PURPOSES OF IDENTIFYING THE LOCATION
OF THE WATER RIGHT ONLY. IT IS
NOT INTENDED TO PROVIDE DIMENSIONS
OR LOCATION OF PROPERTY OWNERSHIP
LINES.