


CLAIM OF BENEFICIAL USE  
 FOR: ANN HEYSELL KJENSRUD  
 BY: DUANE W. KIRBY  
 T26S, R4W WM, SEC 19  
 PERMIT NO S-54314  
 APPLICATION NO. S-86263  
 LOT NOS 300 7 400

FISH SCREEN IS LOCATED AT THE POD  
 1500 GALLON STORAGE TANK LOCATED AT THE PUMP HOUSE

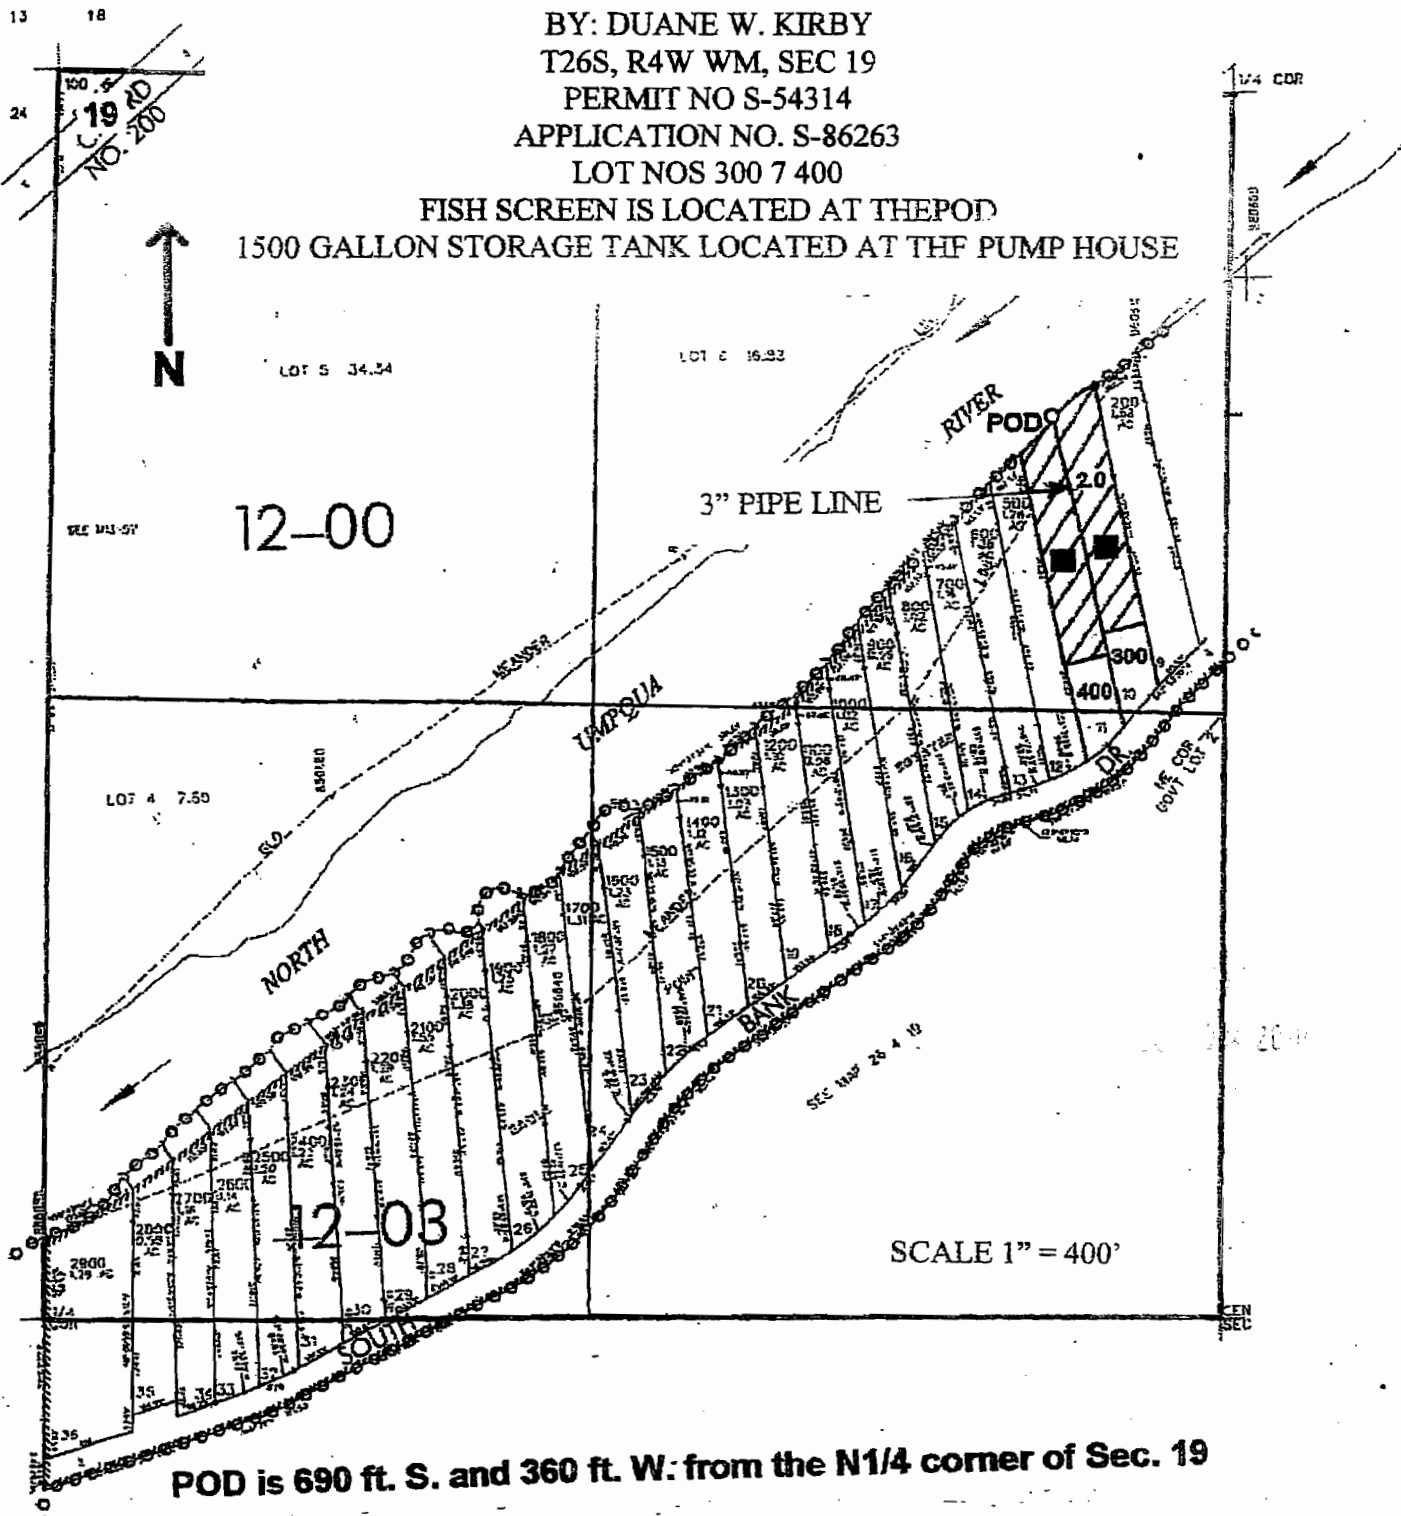

POD is 690 ft. S. and 360 ft. W. from the N1/4 corner of Sec. 19

THE PURPOSE OF THIS MAP IS TO IDENTIFY THE LOCATION OF THE WATER RIGHT. IT IS NOT INTENDED TO PROVIDE INFORMATION RELATIVE TO THE LOCATION OF PROPERTY OWNERSHIP BOUNDARY LINES.

