


T. 23S., R. 33E., W.M.

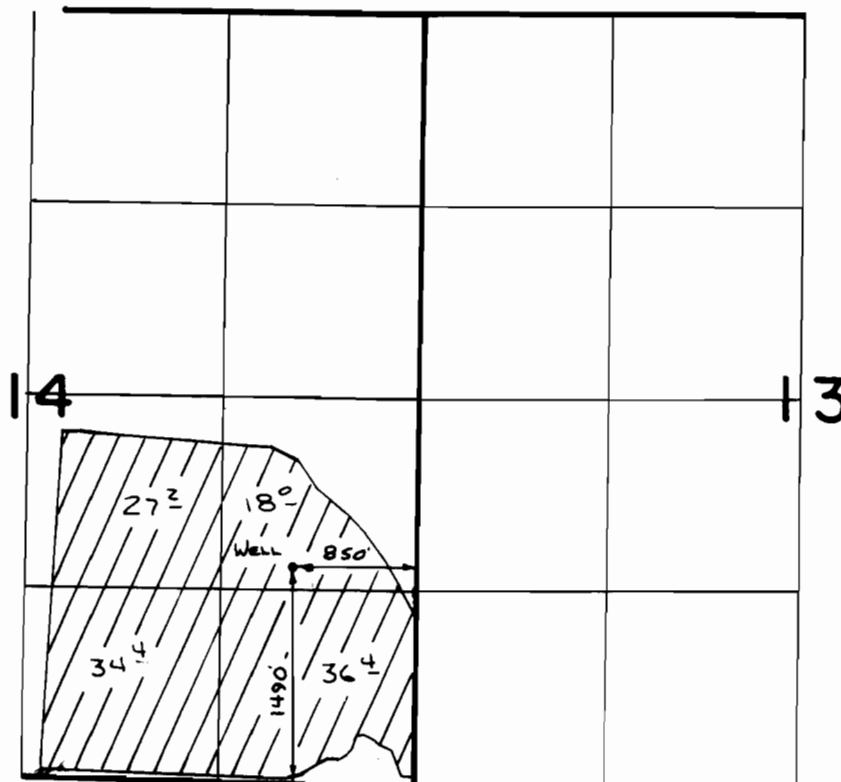

SCALE 1" = 1320'

FINAL PROOF SURVEY
UNDER

Application No. **G:8464** Permit No. **G:7763..**
IN NAME OF

RAMON K. HANSON

Surveyed **5-9** 19**88**, by **Z. Saleh**