


RECORDED

001 22 2010

# T.12S., R.1W., W.M.

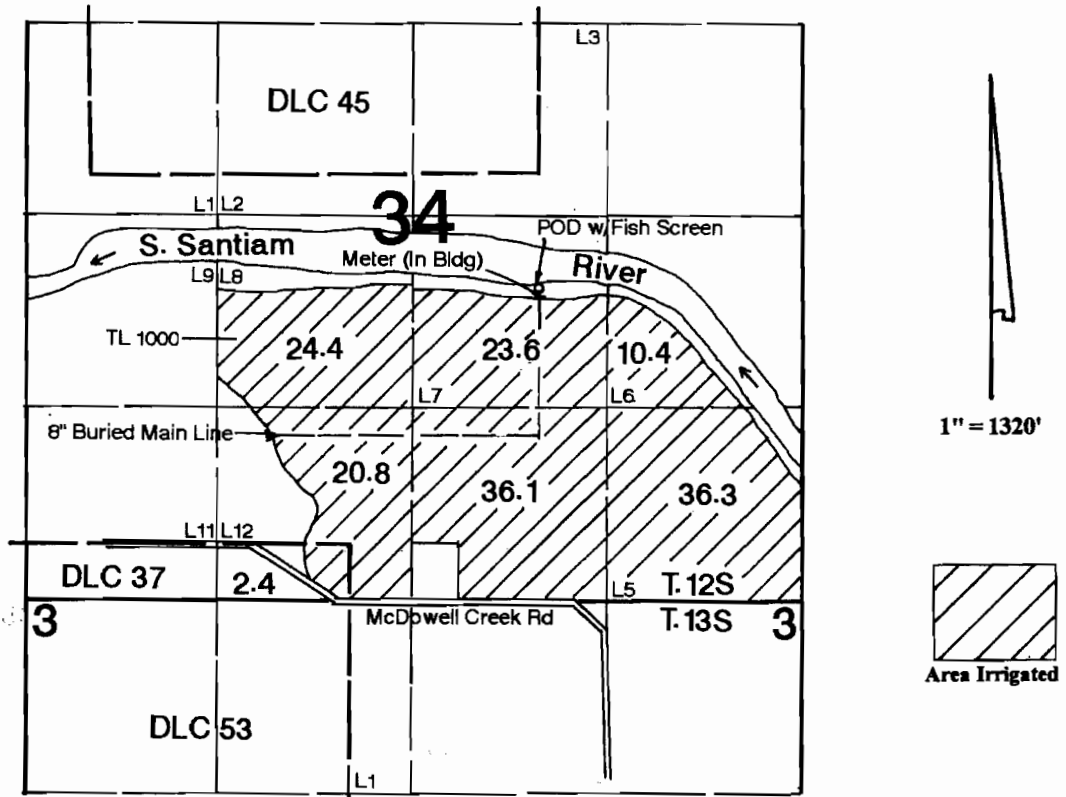

POD is located 2,170'N & 1,810'W from the SE corner of Section 34.

## Claim of Beneficial Use

In the Name of

# Santiam Properties, LLC

Transfer #: T-10657

Surveyed on September 29, 2010 by JM Schuette

This Map was Prepared for the Purpose of Identifying the Location of a Water Right Only and is Not Intended to Provide Legal Dimensions or Location of Property Ownership Lines.

