


RECEIVED

JUN 08 2009

LOWER GORMAN CRK. RES. #1 & #2
UPPER CRANE CREEK RANCH

WATER RESOURCES DEPT
SALEM, OREGON

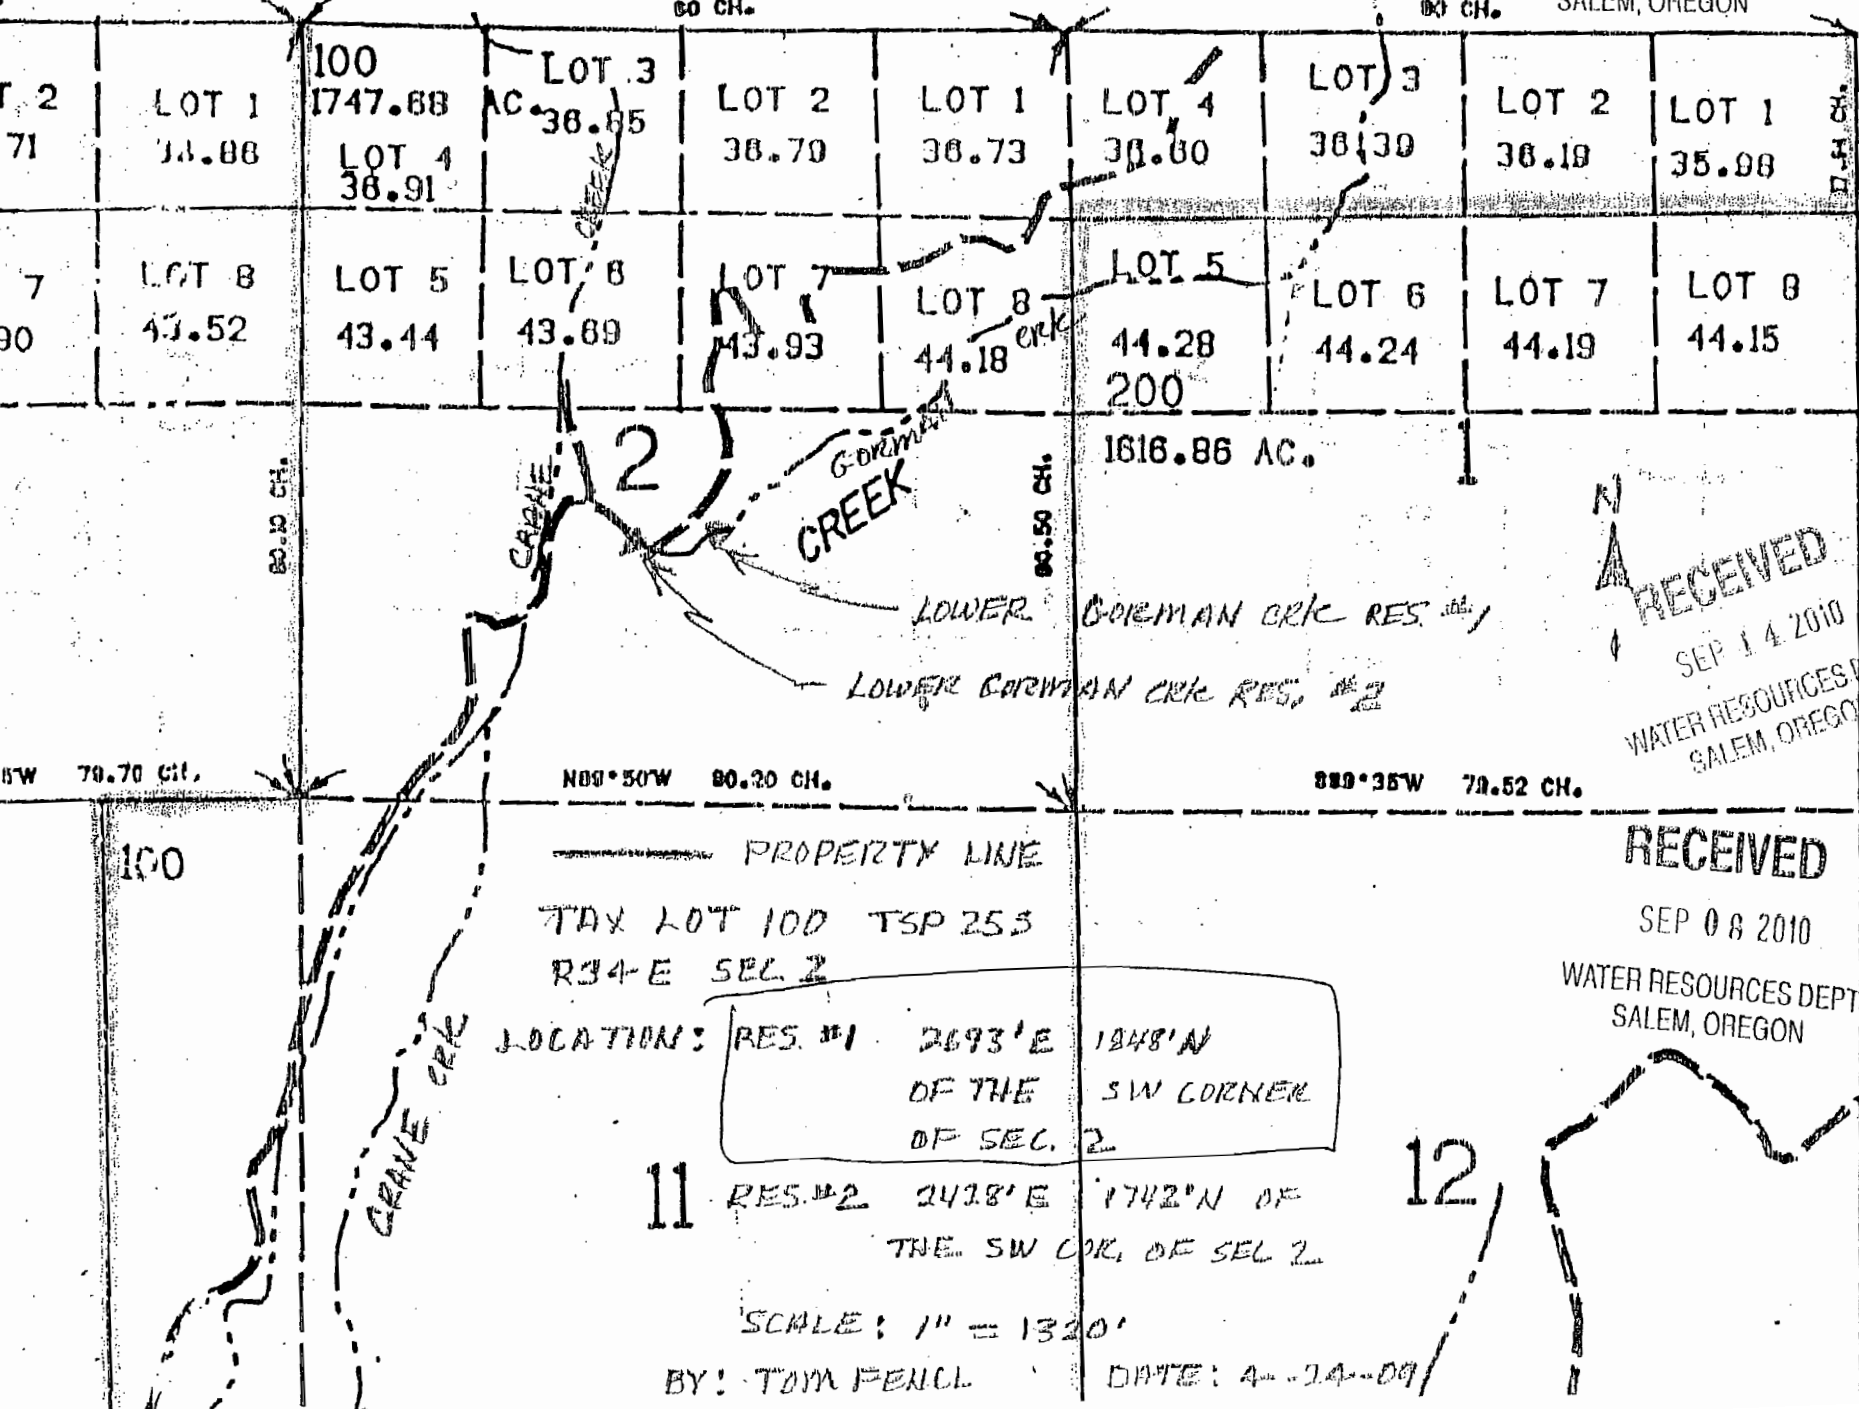

RECEIVED

SEP 14 2010

WATER RESOURCES DEPT
SALEM, OREGON

RECEIVED

SEP 08 2010

WATER RESOURCES DEPT
SALEM, OREGON