

RECEIVED

OCT - 2 1996

WATER RESOURCES DEPT.  
SALEM, OREGON

T. 2 N., R. 32 E.

T. 2 N., R. 33 E.

N.E. RIVERSIDE AVE

SW 1/4, SW 1/4

SE 1/4, SE 1/4

6

7

NW 1/4, NW 1/4

0.61 ACS.

12

4.06 ACS.

8.01 ACS.

*This portion was sold  
to Randy & Vicki Leonard  
915 N.E. 41st St  
Pendleton, OR  
99801*

UMATILLA

NE 1/4, NE 1/4

POD S 2°22'30" E  
448.2' NE SEC 12

1912 WATER  
RIGHT LIMIT

RIVER

RECEIVED

OCT 25 2010

WATER RESOURCES DEPT  
SALEM, OREGON

**K** KRUMBEIN ENGINEERING LTD.  
ENGINEERS - SURVEYORS - PLANNERS  
361 S.E. Second Pendleton, Oregon

Scale  
1"=400'

Drn. By  
HP

Drng. No.  
9629A

Revision 1


Date  
9-26-96

Ckd. By  
DHK

Job No.  
9313

Revision 2

FINAL PROOF MAP &  
CLAIM OF BENEFICAL USE  
HUNT  
SEC. 1 & SEC. 12, T2N., R32E  
SEC. 7, T. 2 N., R 33E. W.M.

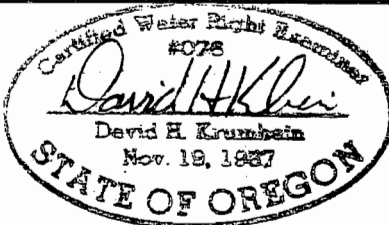

RENEWS 6/30/97

T-6981