T. 38 S., R.10 & 11 1/2 E., W.M.

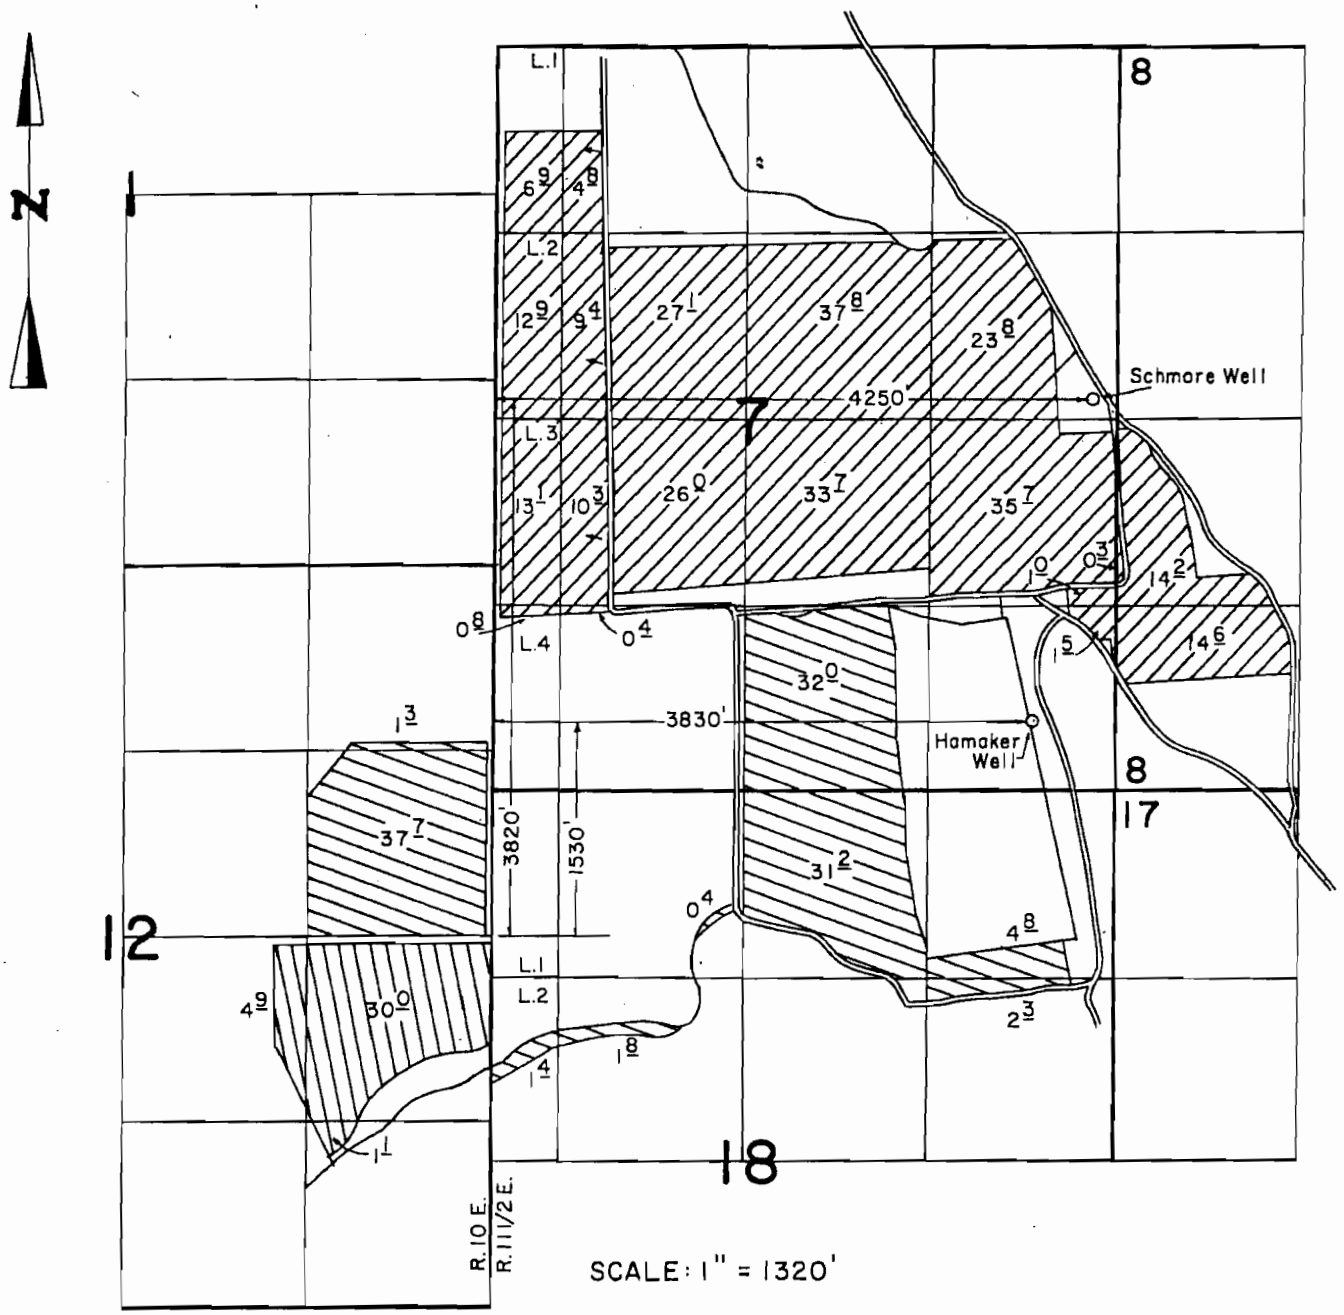

FINAL PROOF SURVEY

UNDER
TRANSFER NO. 3486 ..... Primary (HAMAKER WELL)
" " " ..... Supplemental " "

Application No. G-7396 Permit No. G-6835 ..... Primary (SCHMORE WELL)
IN NAME OF

C.W. BIAGGI & T.M. VENABLE

Surveyed SEPT. 20 1989, by B.W. BISHOP

1-23-90
41035-178-109D