


SE 1/4 T37S R5W Sec 19

RECEIVED

DEC 27 2010

WATER RESOURCES DEPT
SALEM, OREGON

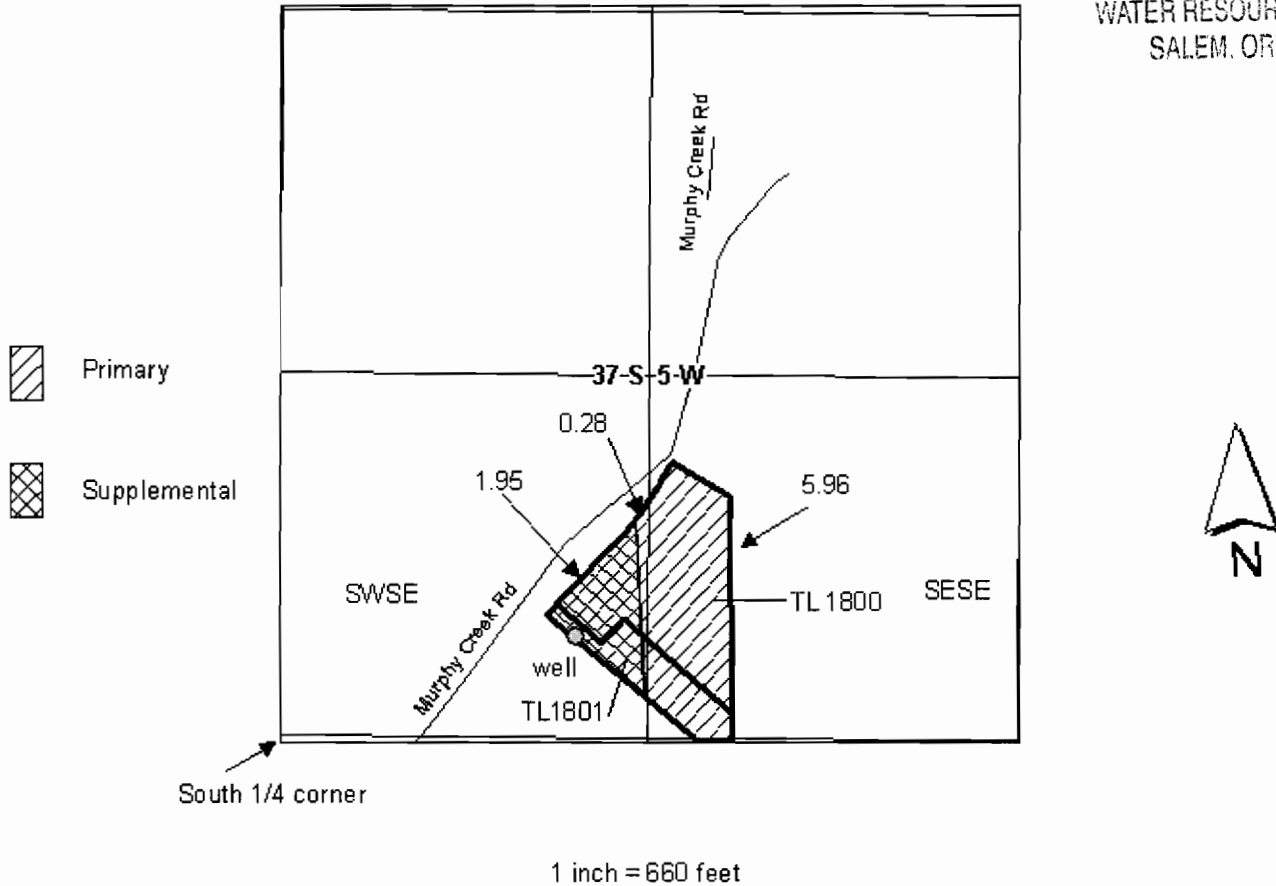

Well is located 362 ft north and
1057 ft east from south 1/4
corner Sec 19

FINAL PROOF SURVEY

UNDER

Application No. G11655.....Permit No. G10829

IN NAME OF

John M. & Diana L. Flaherty, Jr.

December 15, 2010