


RECEIVED

NOV 24 2010

RESOURCES DEPT
ASHEM, OREGON

T.35S.R7W. W.M.

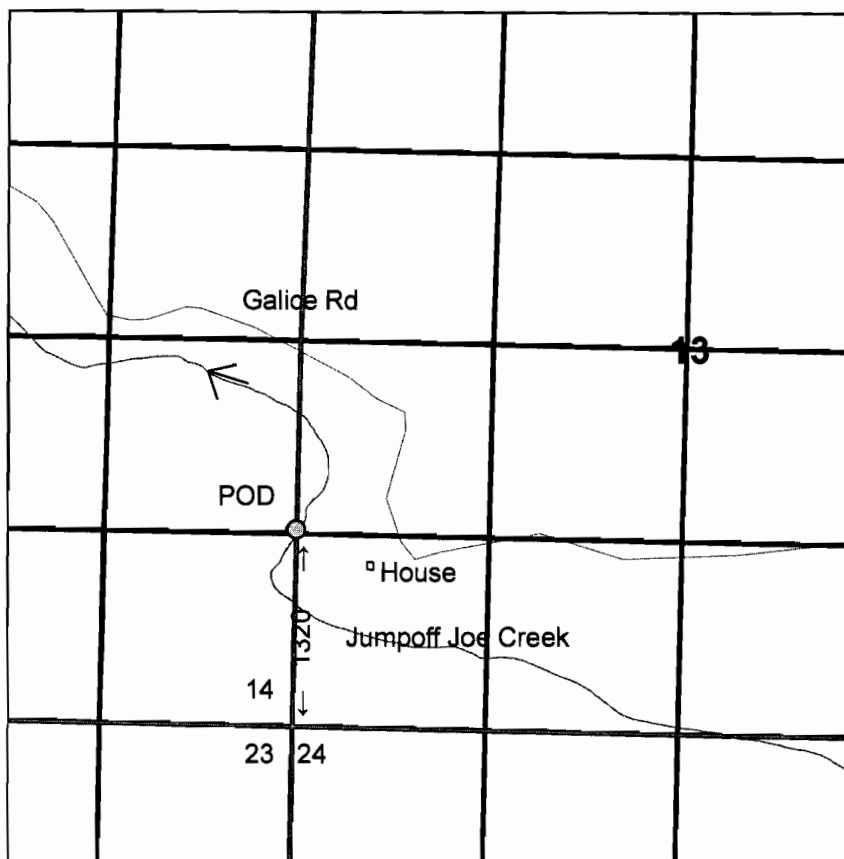

**FINAL PROOF SURVEY
UNDER**

APPLICATION NO. 69034 Permit No. 49984

IN NAME OF

Frederick G. & Nancy M. Sharp

Surveyed June 21, 1994, by B. Sue DeHaas

1 inch = 1,320 feet

KS 41033 179 165R