
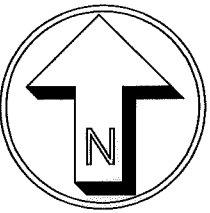


FINAL PROOF MAP – PERMIT G-12853

LOCATED IN
SECTIONS 27 & 28, T. 19 S., R. 22 E., W.M.
CROOK COUNTY, OREGON

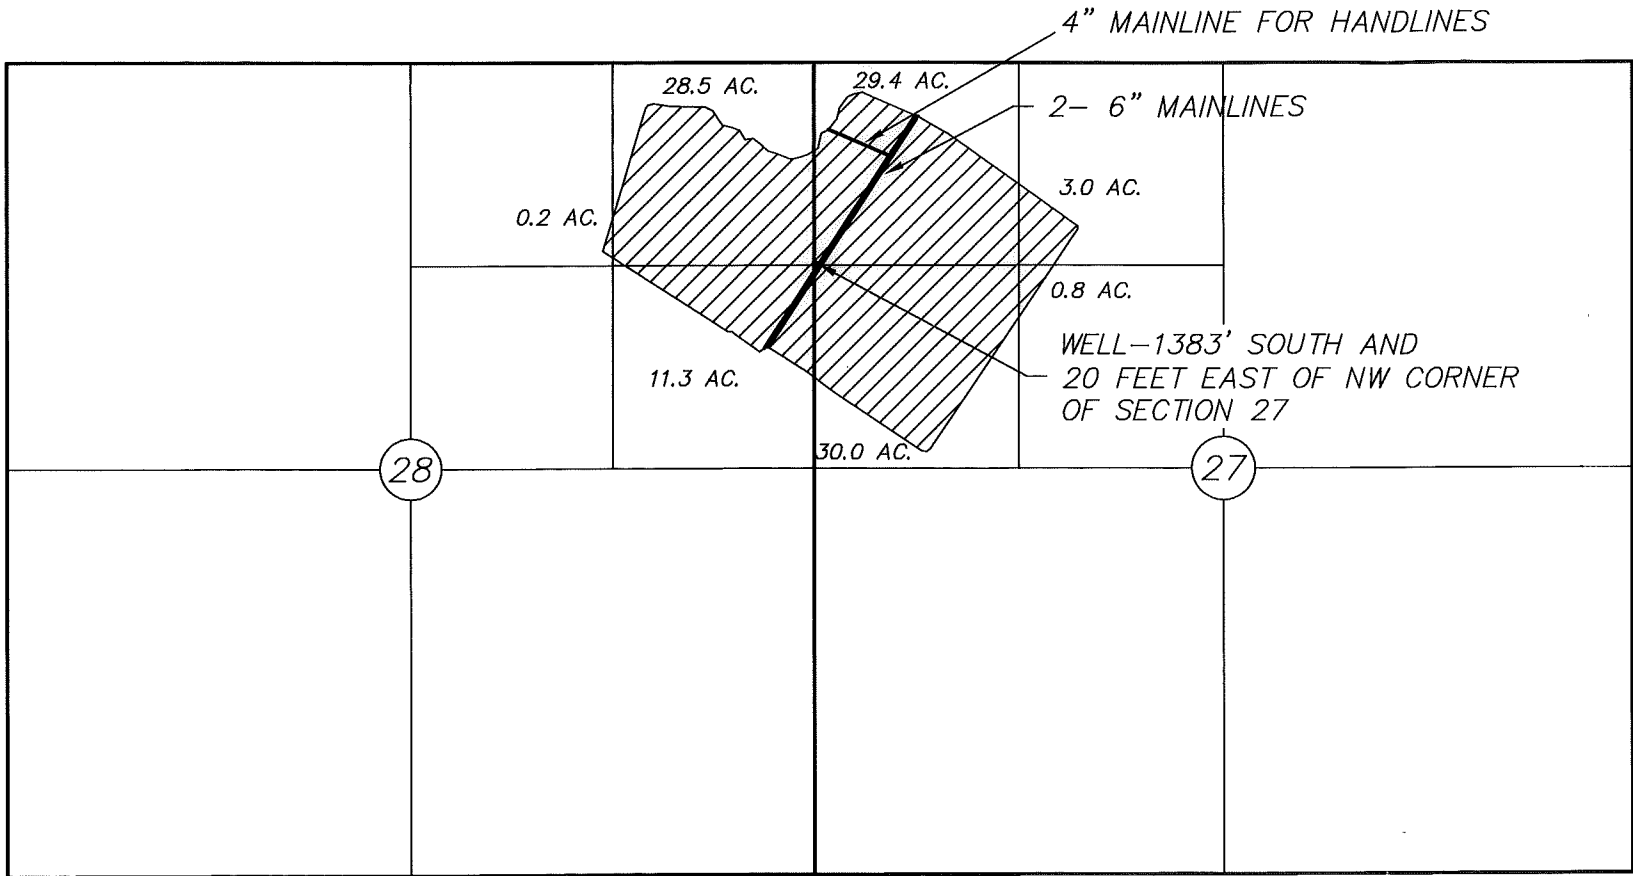


 = IRRIGATED AREA

I, ROBERT E. BAXTER, CERTIFIED WATER RIGHT EXAMINER
IN THE STATE OF OREGON, HEREBY CERTIFY THAT THIS
WATER RIGHT SURVEY MAP WAS PREPARED BY ME.

THE PREPARATION OF THIS MAP IS FOR THE PURPOSE
OF IDENTIFYING THE LOCATION OF THE WATER RIGHT
ONLY AND HAS NO INTENT TO PROVIDE DIMENSIONS OR
LOCATIONS OF PROPERTY OWNERSHIP LINES.

RECEIVED
APR 20 2000
WATER RESOURCES DEPT.
SALEM, OREGON

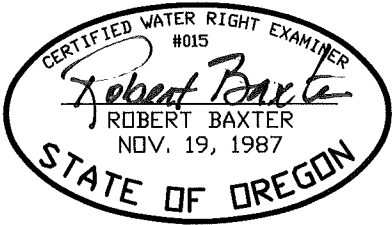

PREPARED BY BAXTER LAND SURVEYING, INC. 20370 EMPIRE AVE. SUITE C3 BEND, ORE. 97701 (541) 382-1962	FINAL PROOF MAP FOR NORM HYATT	PREPARED FOR: NORM HYATT HC 67, BOX 550 PRINEVILLE, OREGON 97754 (541)-477-3533 SCALE: 1" = 1320' DATE: 4-12-00
---	--------------------------------------	---