


T 39 S, R 3 W, W.M.

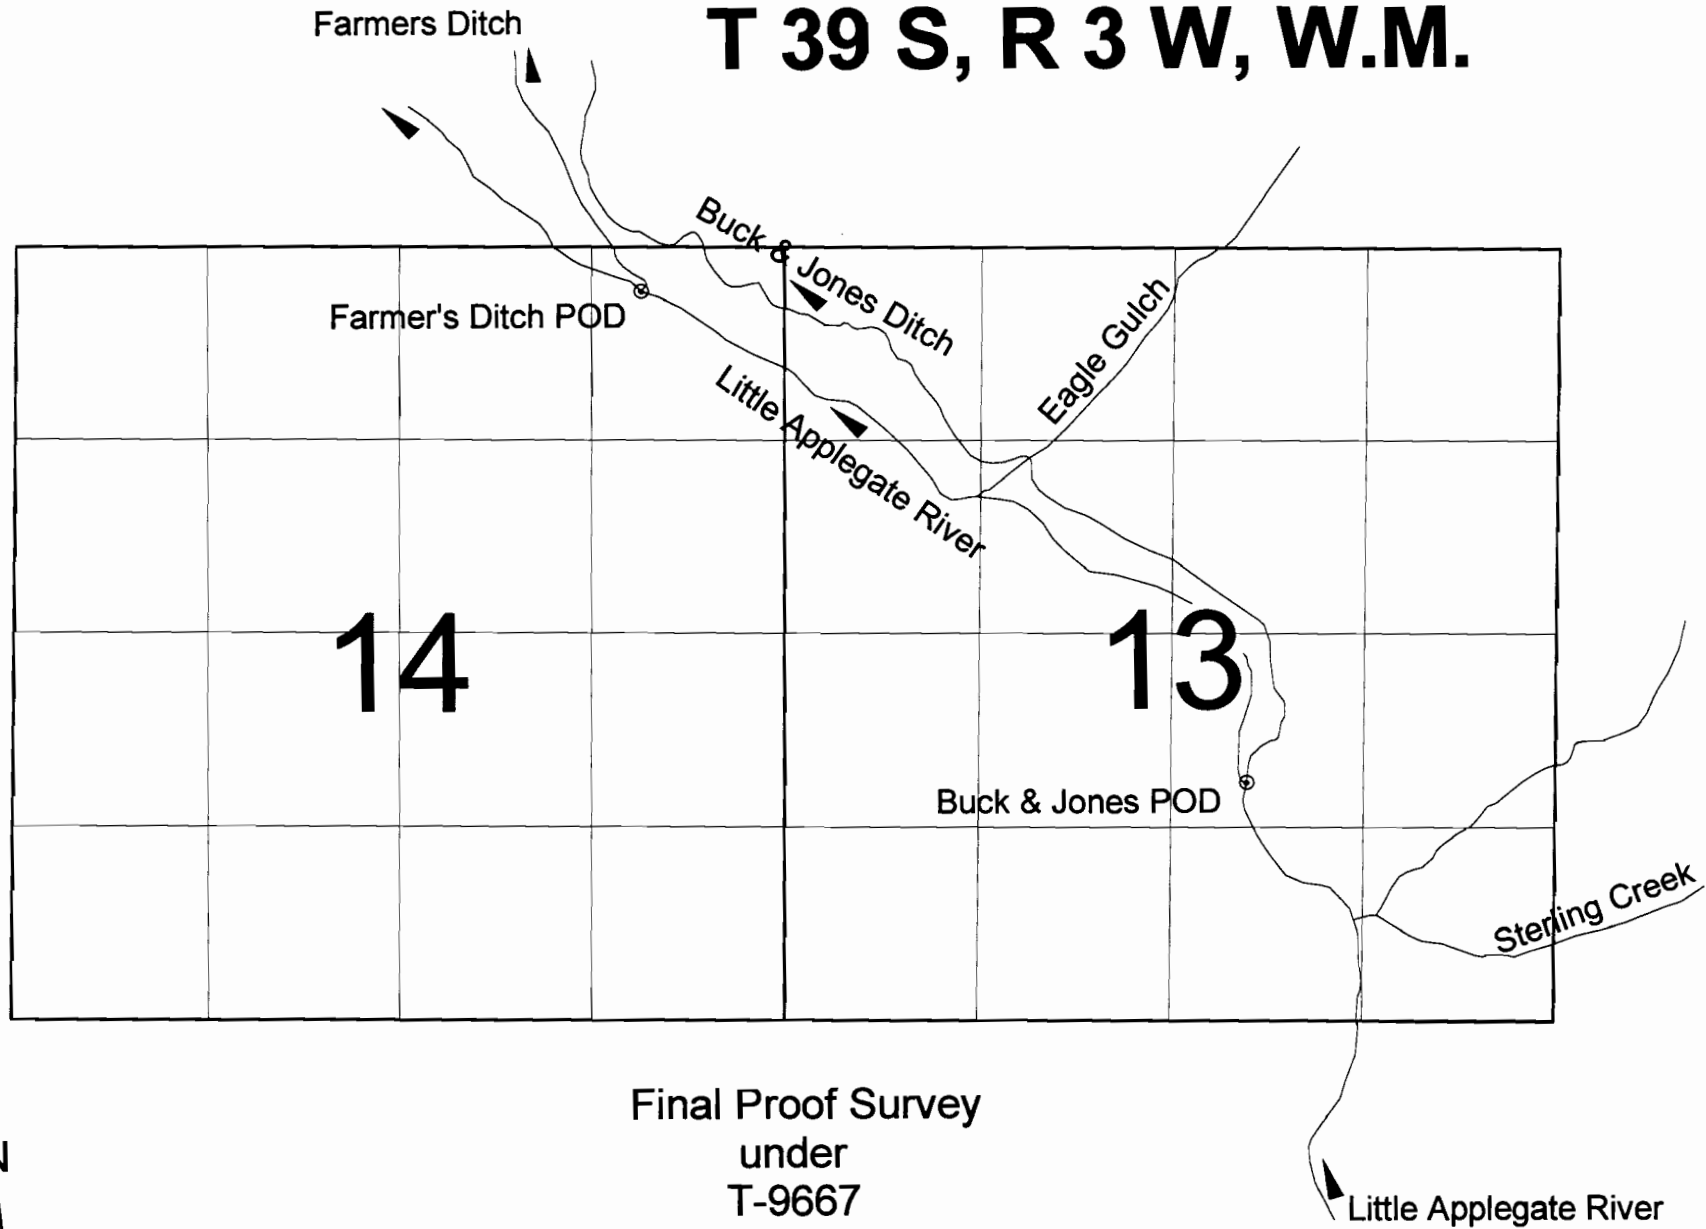

Final Proof Survey
under
T-9667




Farmer's Ditch POD - GPS coordinates: Latitude 42.18400, Longitude -123.0174
Buck & Jones Ditch POD - GPS coordinates: Latitude 42.17508, Longitude -123.0018



Scale 1 inch = 1320 feet

9667
FINAL PROOF MAP T~~9665~~
 NW1/4SW1/4, SW1/4SW1/4, SEC. 34, T.38S., R.3W., W.M.
 JACKSON COUNTY, OREGON
 FOR
JUDITH A. WELLS
 126 HAMILTON ROAD
 JACKSONVILLE, OR 97530



T.38S., R.3W., Sec. 34

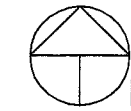

Scale: 1"=400'
 Date: June 16, 2006

LEGEND


- Found Survey Monument
- Denotes Building
- Ⓜ Flow Meter
- BP Booster Pump
- Denotes area under Special Order Volume 68, Pages 3-6, Priority Date 1858
- Denotes area under Special Order Volume 68, Pages 3-6, Priority Date Aug. 29, 1961

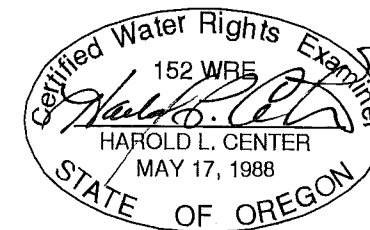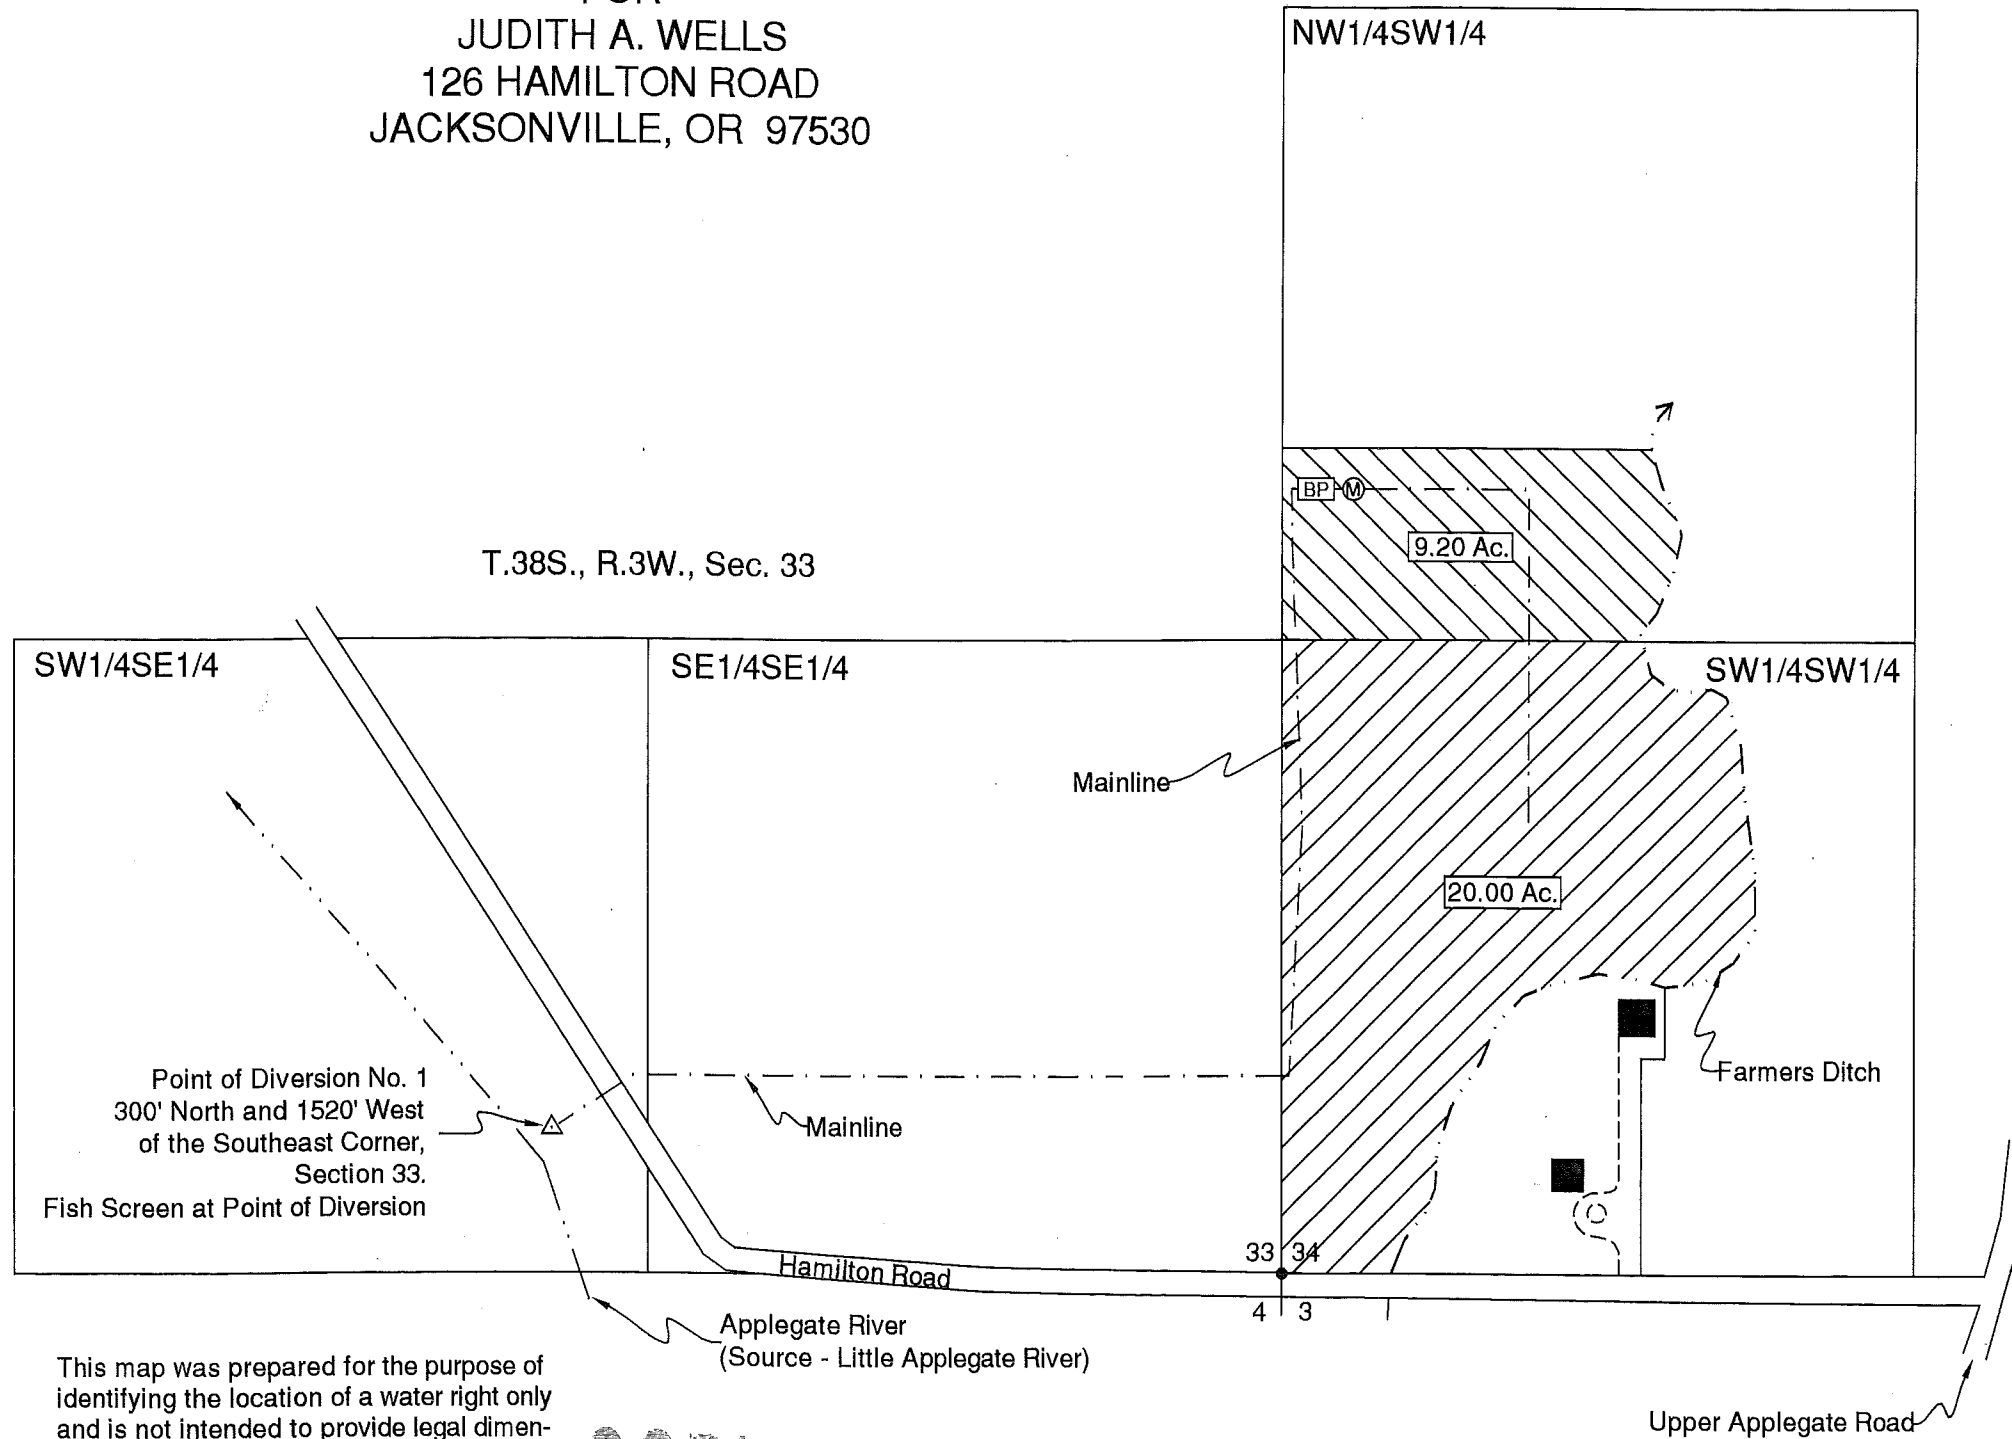

HAROLD L. CENTER
 2604 David Lane
 Medford, OR. 97504
 Phone 541-535-6108
 Oregon Certificate No. 152
 Certificate Renewal Date: 12/31/2007

This map was prepared for the purpose of identifying the location of a water right only and is not intended to provide legal dimensions or location of property ownership.

COBU MAP # 0216

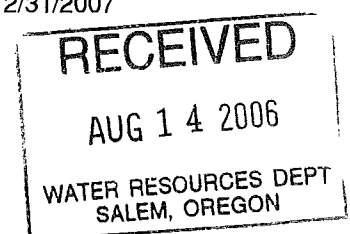

0216