


T.9S.; R.39E.; W.M.

Location NE $\frac{1}{4}$ SW $\frac{1}{4}$; SE $\frac{1}{4}$ SW $\frac{1}{4}$; SW $\frac{1}{4}$ SW $\frac{1}{4}$ SECTION 4
and the NW $\frac{1}{4}$ NW $\frac{1}{4}$ SECTION 9 T.9S.; R.39E.; W.M.
Baker County Oregon

Tom Mac Kenna

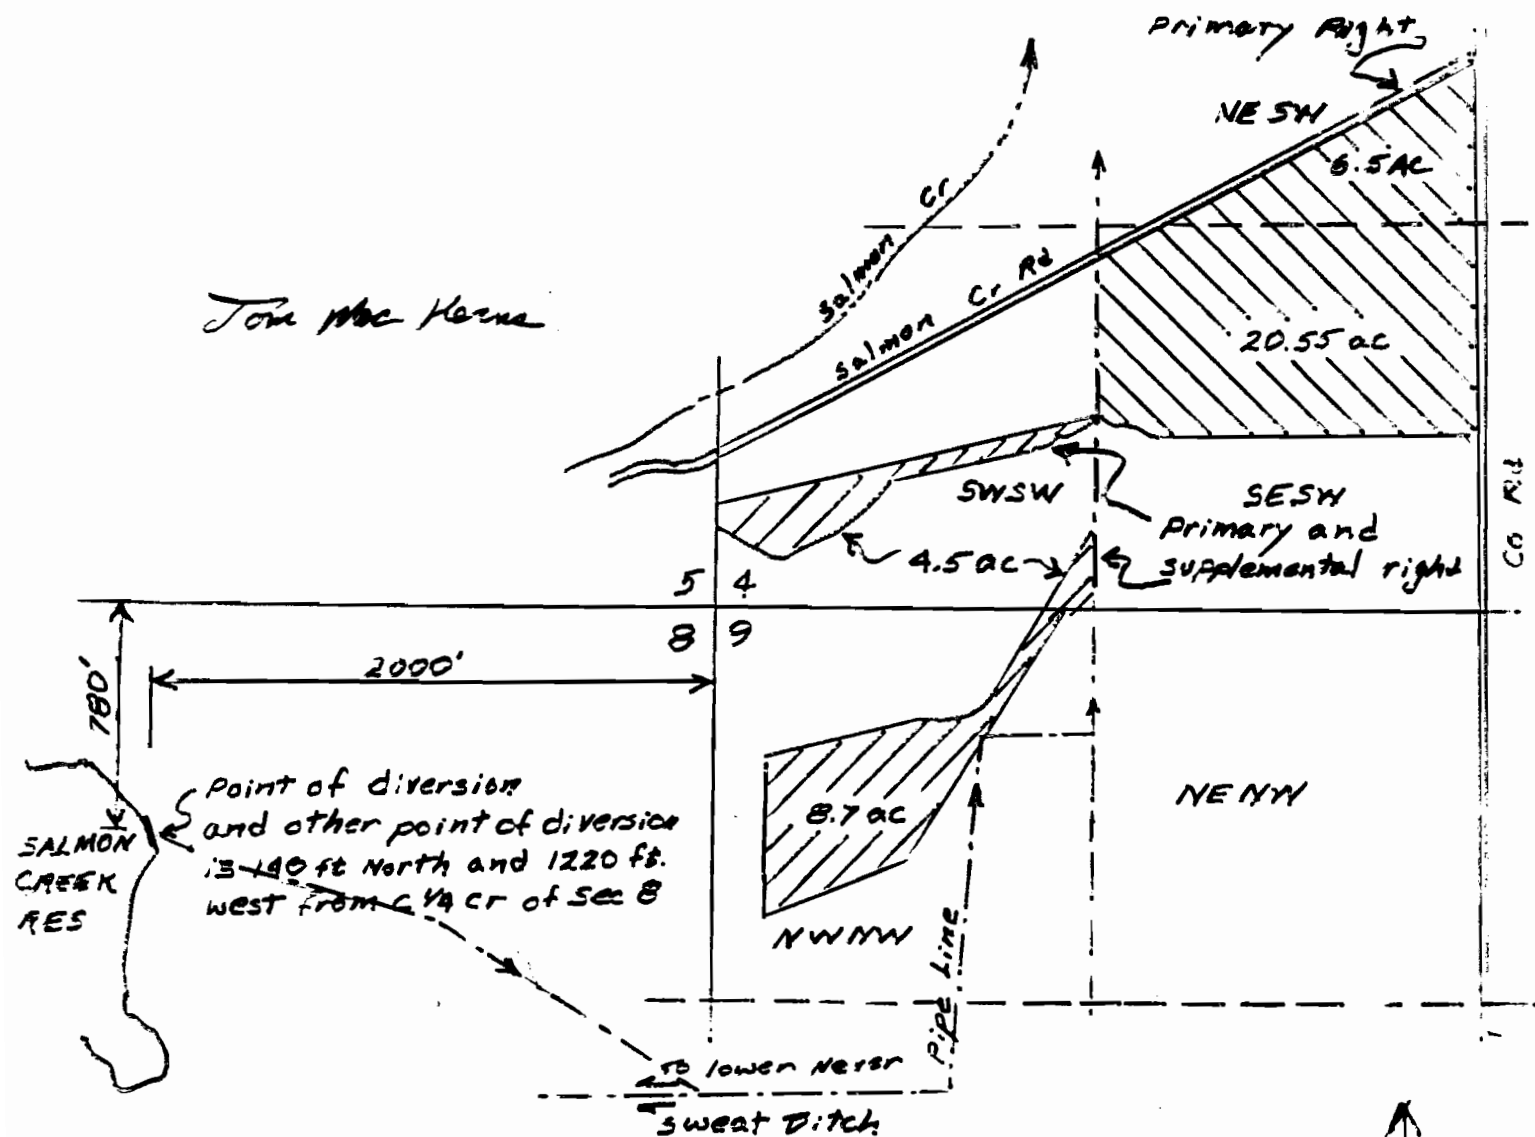

I certify the information provided in this Final Proof is an accurate representation of the water use and is true and correct to the best of my knowledge. This map is to be used for the purpose of identifying the location of water rights only and is not intended to provide legal dimensions or locations of property ownership lines

Tom Mac Kenna CWR

FINAL PROOF SURVEY

under

Application No. 70034 Permit No 51732
in name of

HARELL LAND AND LIVESTOCK LTD

surveyed Dec 15, 1996

Drawn TMR
Scale 8 in = 1 mi.