


T. 9 S., R. 39 E., W.M.

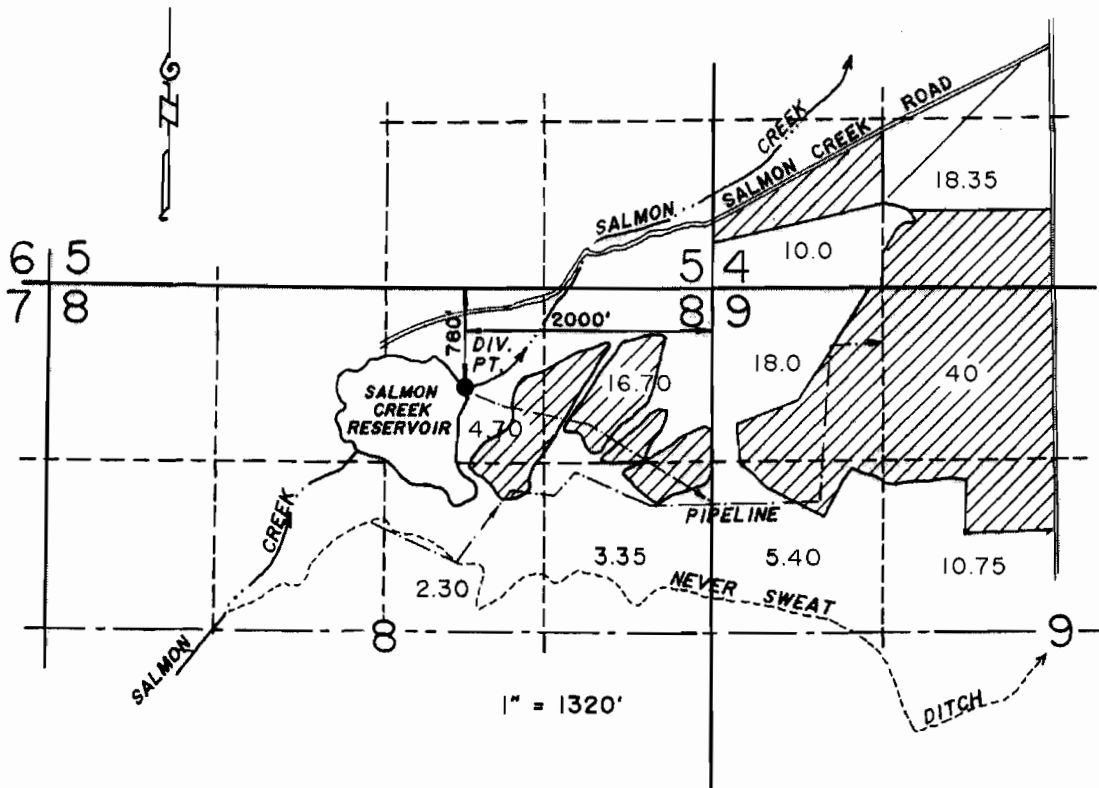

THE PURPOSE OF THIS MAP IS FOR IDENTIFYING THE LOCATION OF THE WATER RIGHT ONLY AND IS NOT INTENDED TO PROVIDE LEGAL DIMENSIONS OF PROPERTY OWNERSHIP LINES.

FINAL PROOF SURVEY

TRANSFER 6282

IN NAME OF

HARRELL LAND AND LIVESTOCK, LTD

Surveyed SEPTEMBER 24, 1993

