

RECEIVED

FINAL PROOF MAP  
LOCATED IN  
SECTION 3, T.40S. R.19E., W.M.



LAKE COUNTY, OREGON  
Tax Lot 1001

Application #S-71357 Permit #52845  
Samuel Farr

JAN 2 1990  
WATER RESOURCES DEPT.  
SALEM, OREGON



SCALE  
1" = 1320'

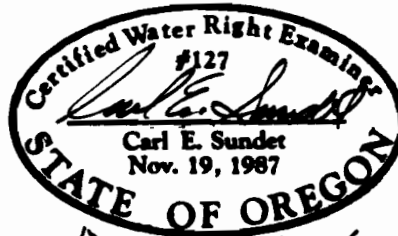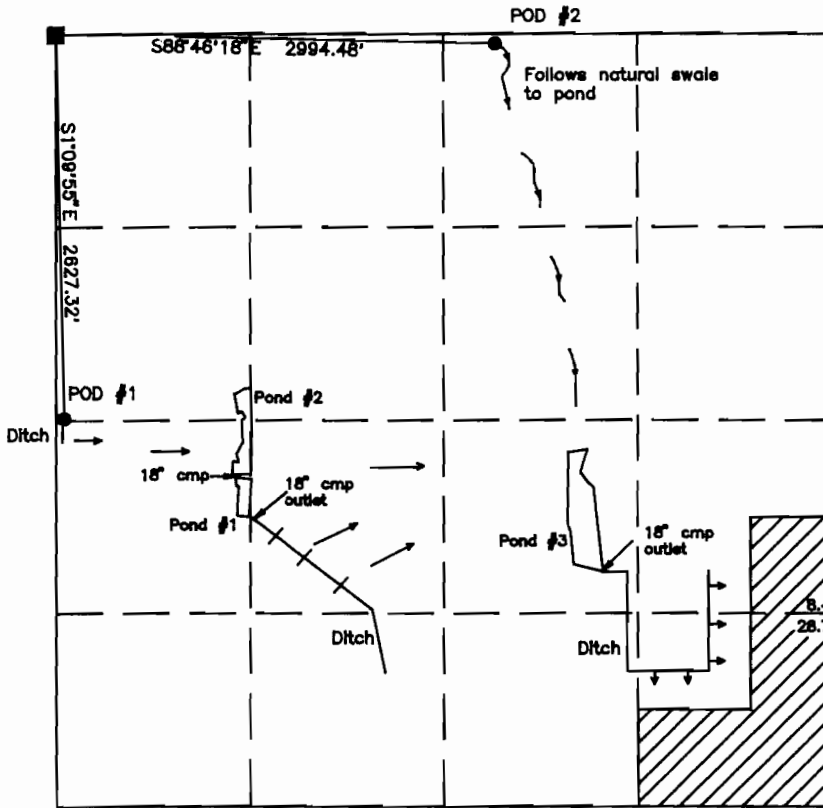

*Renews 6/30/00*

This map is for the purpose of identifying the location of the water right only and is not intended to provide legal dimensions or location of property ownership lines.

Surveyed by: Sundet & Associates  
P.O. Box 1228  
Lakeview, OR 97630  
(541) 947-3293  
Drawing #9798a January 1999