


T. 5 S. R. 2 W. W.M.

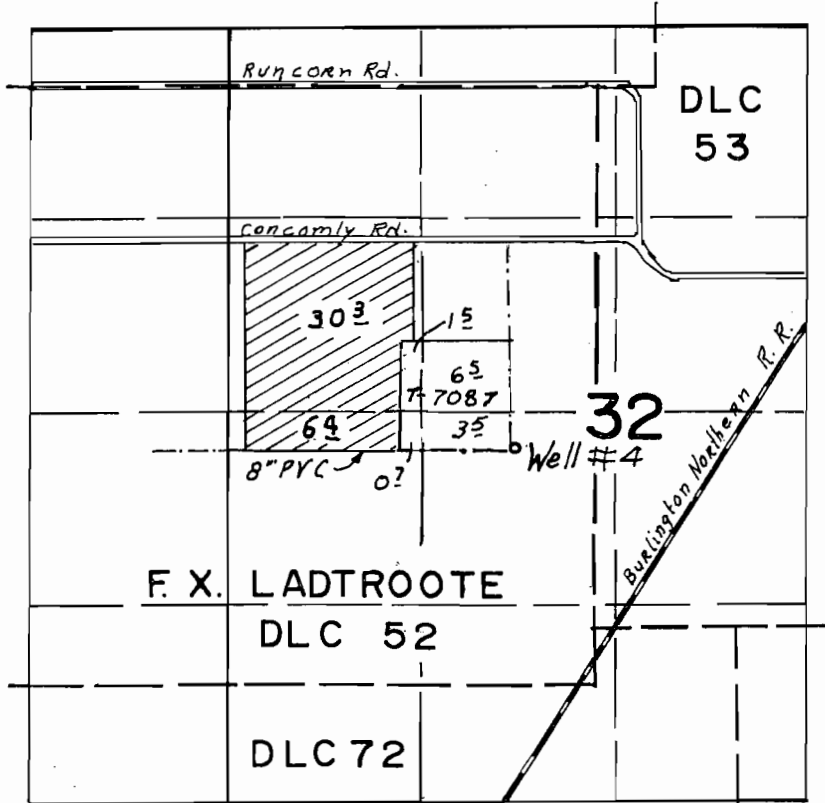

Well #4 loc. 2470' S & 530' W. from NE Cor. DLC 52

RECEIVED

MAY 26 1999


WATER RESOURCES DEPT
SALEM OREGON

FINAL PROOF SURVEY UNDER

Application No. G-13603 Permit No. G-12169
IN NAME OF

ROBERT & PAMELA ZIELINSKI

Surveyed May 4, 1999, by

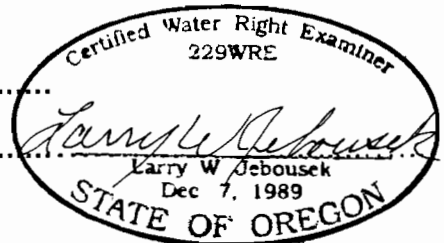

THIS MAP WAS PREPARED FOR THE PURPOSE OF IDENTIFYING THE LOCATION OF A WATER RIGHT ONLY AND IS NOT INTENDED TO PROVIDE LEGAL DIMENSIONS OR LOCATION OF PROPERTY OWNERSHIP LINES.

WAC Marion Co. - 92 5B-10