


RECEIVED

DEC 31 1997

WATER RESOURCES DEPT.  
SALEM, OREGON

T.5S. R.1W. W.M.

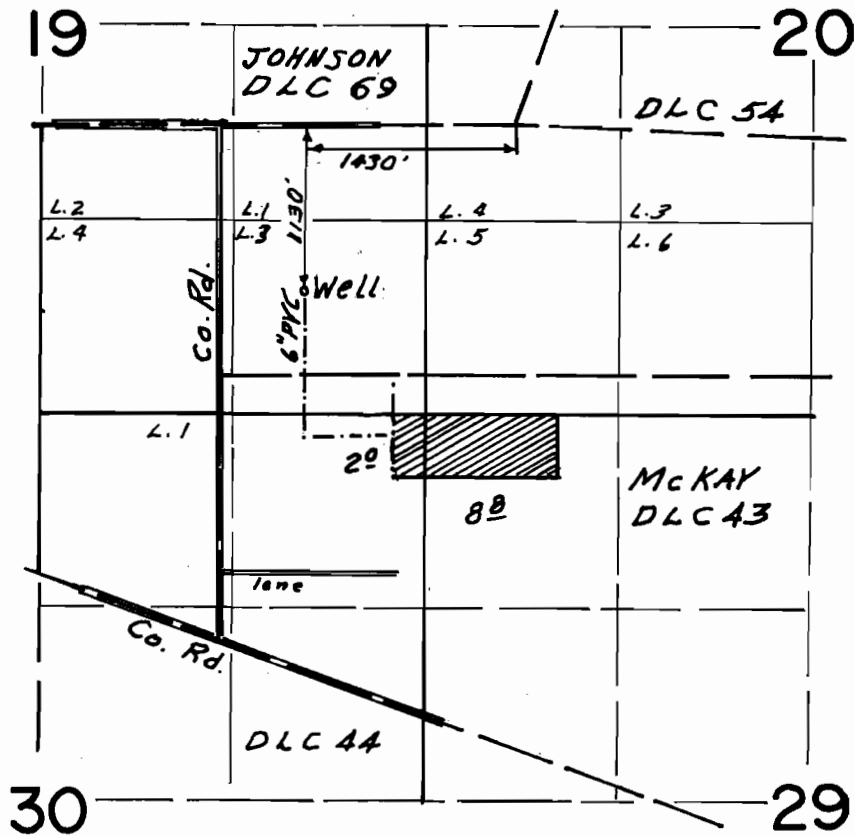


**FINAL PROOF SURVEY**  
UNDER

Application No. ~~C-13302~~ Permit No. ~~G-11982~~  
IN NAME OF

DAVID OBERSINNER

Surveyed Aug. 13, 1997, by

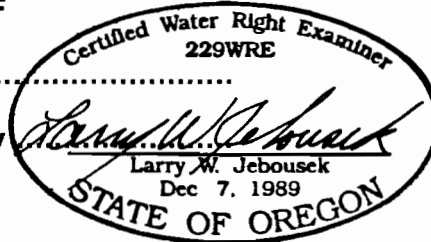

THIS MAP WAS PREPARED FOR THE PURPOSE OF IDENTIFYING THE LOCATION OF A WATER RIGHT ONLY AND IS NOT INTENDED TO PROVIDE LEGAL DIMENSIONS OR LOCATION OF PROPERTY OWNERSHIP LINES.