


RECEIVED

JEC 16 2010

WATER RESOURCES DEPT
SALEM OREGON

POD #1
100' N & 300' E
from W 1/4 corner
of Section 3

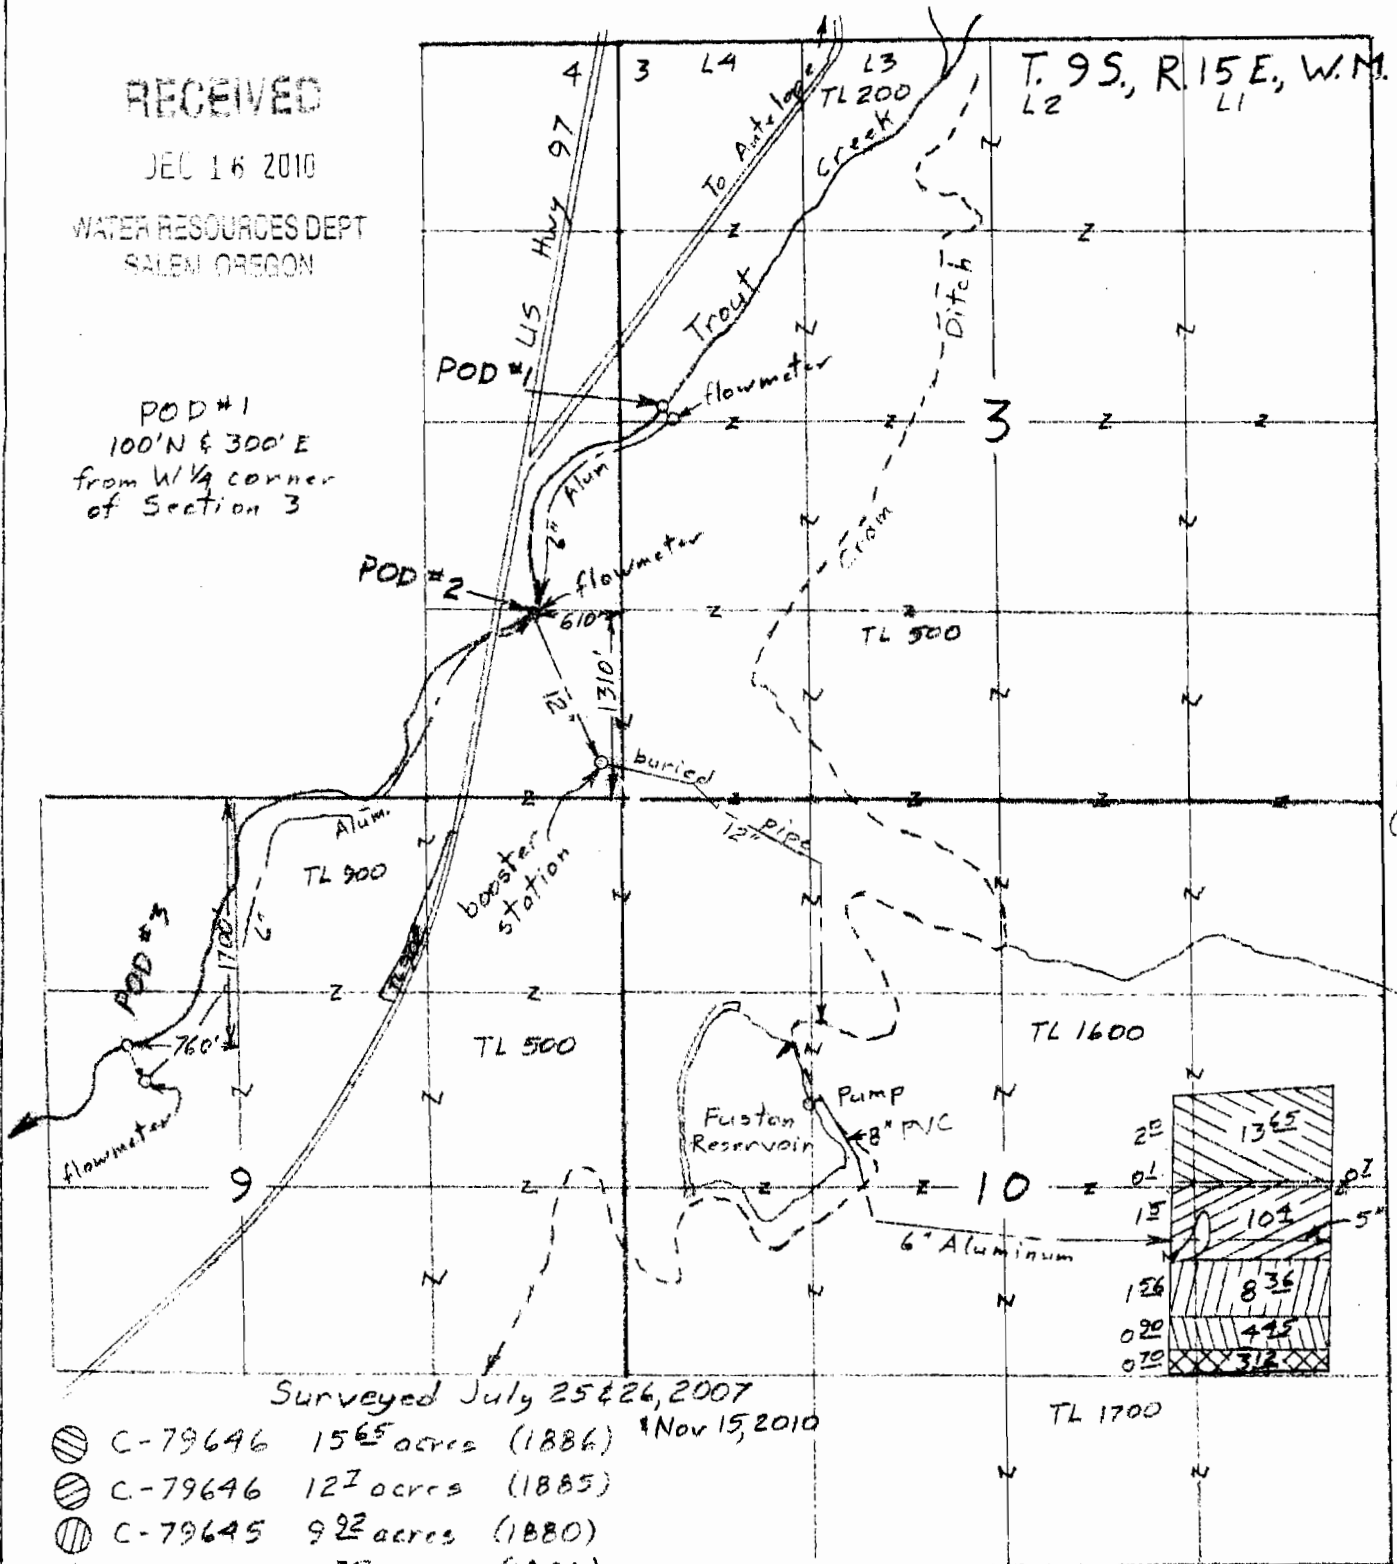

Scale
1" = 1320'
(4" = 1 mile)


Surveyed July 25 & 26, 2007

- ⊗ C-79646 15⁶⁵ acres (1886) Nov 15, 2010
- ⊗ C-79646 12⁷ acres (1885)
- ⊗ C-79645 9²² acres (1880)
- ⊗ C-79647 5³⁵ acres (1880)
- ⊗ C-79648 3⁸² acres (11/4/1915)

Claim of Beneficial Use Map
for
Columbia Empire Farms, Inc.
(R-2 Ranch)

Transfer T-9188

This map is for the purpose of
locating a water right only
and has no intent to provide
legal dimensions or the location
of property lines.

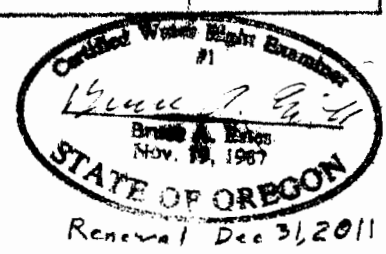

ESTES SURVEYS
 PO Box 17619 80052 Arnold Rd
 Salem, OR 97306-7619 Bend, OR 97702
 (803) 566-7893 (541) 382-7381