


RECEIVED

JEC 16 2010

WATER RESOURCES DEPT
SALEM OREGON

POD #1
100' N & 300' E
from W 1/4 corner
of Section 3

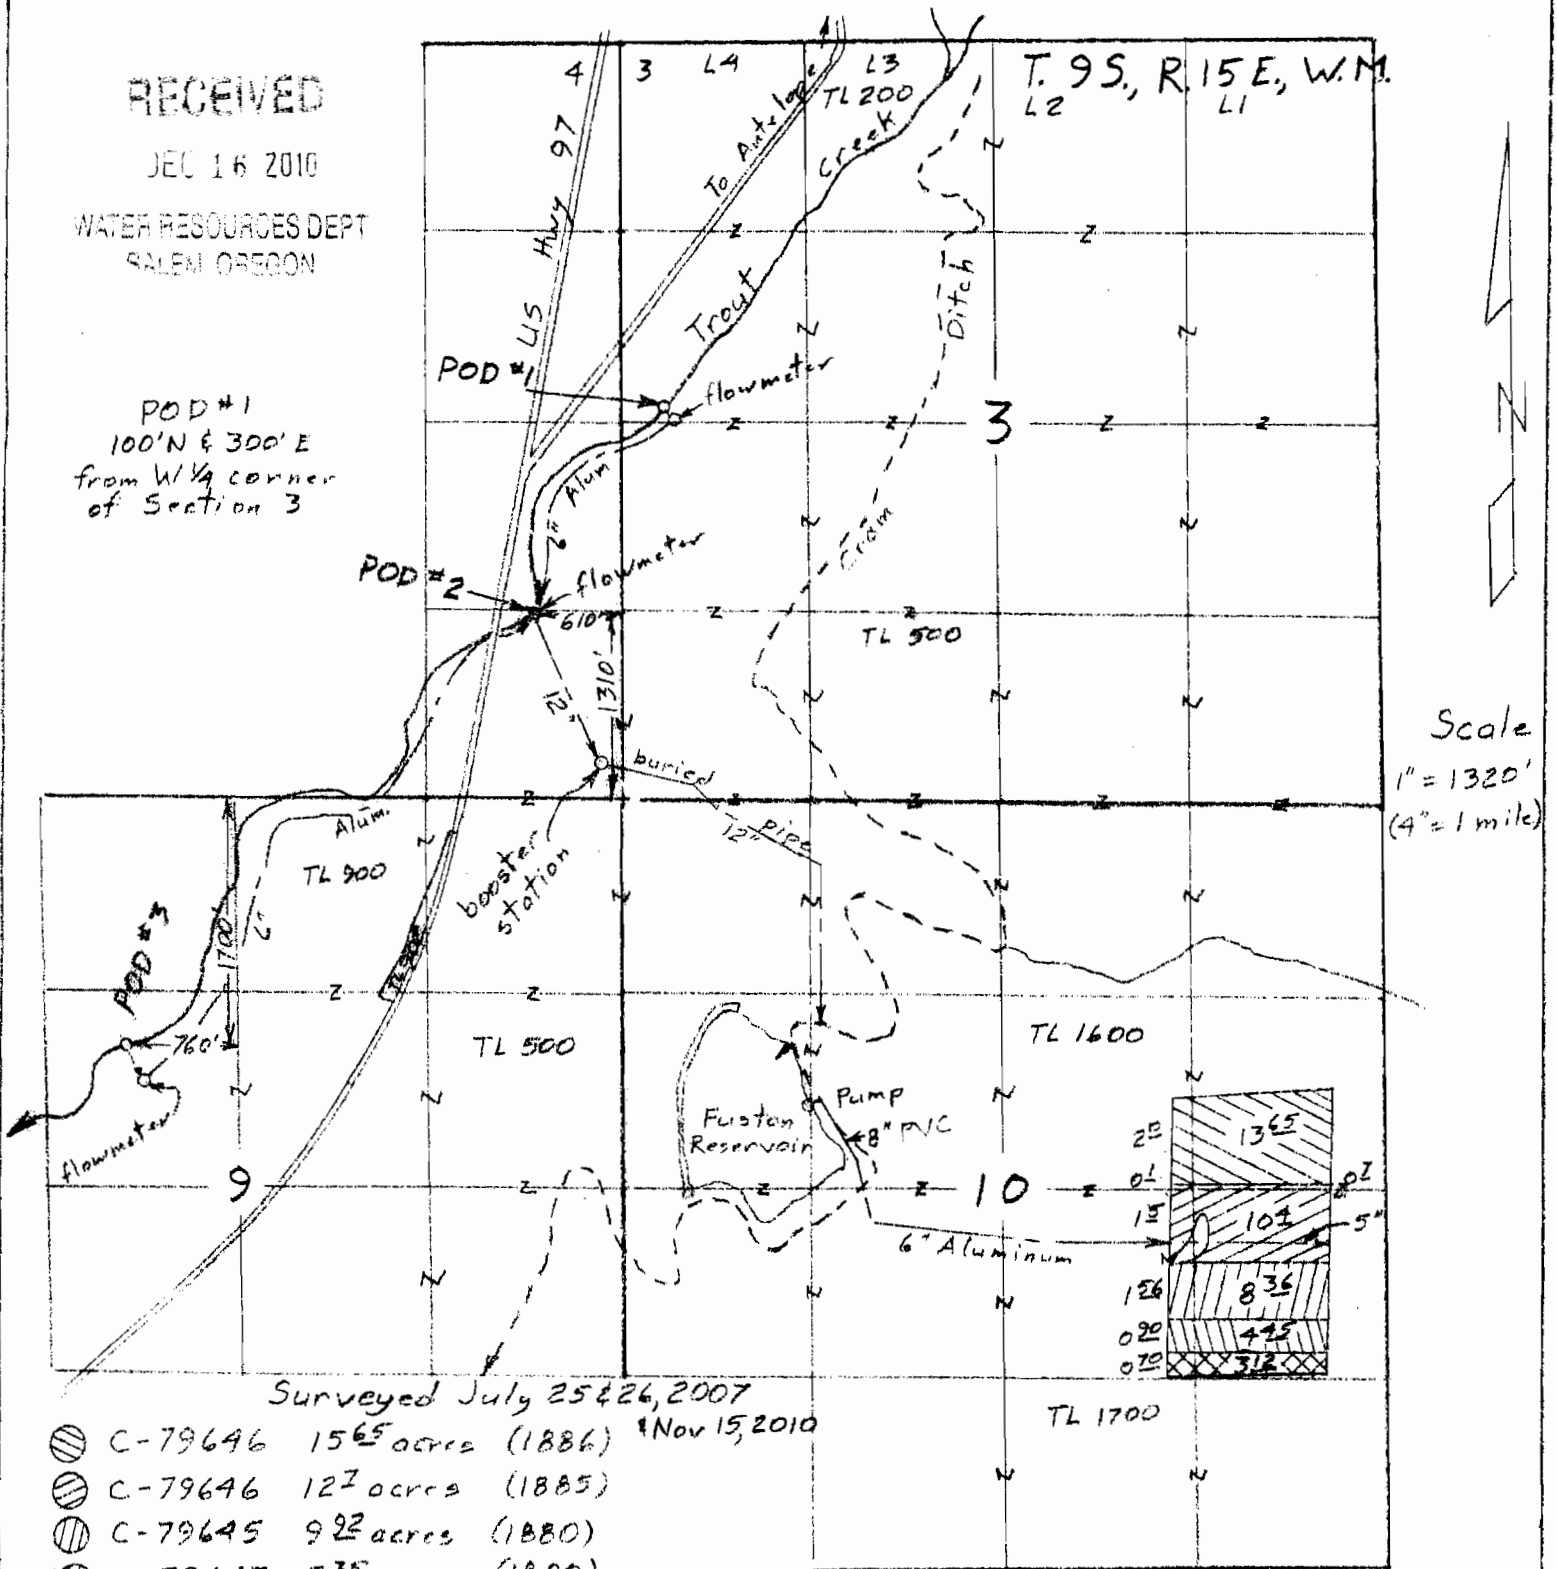

Scale
1" = 1320'
(4" = 1 mile)


Surveyed July 25 & 26, 2007

- ⊗ C-79647 53⁵ acres (1880)
- ⊗ C-79648 38² acres (11/4/1915)

Claim of Beneficial Use Map
for
Columbia Empire Farms, Inc.
(R-2 Ranch)

Transfer T-9188

This map is for the purpose of
locating a water right only
and has no intent to provide
legal dimensions or the location
of property lines.

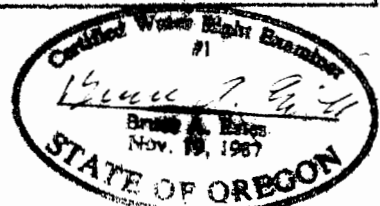

Renewal Dec 31, 2011

ESTES SURVEYS

P.O. Box 17619 80552 Arnold Rd
Salem, OR 97306-7519 Bend, OR 97702
(503) 566-7893 (541) 382-7391