



TOWNSHIP 14 SOUTH, RANGE 14 EAST, W.M.

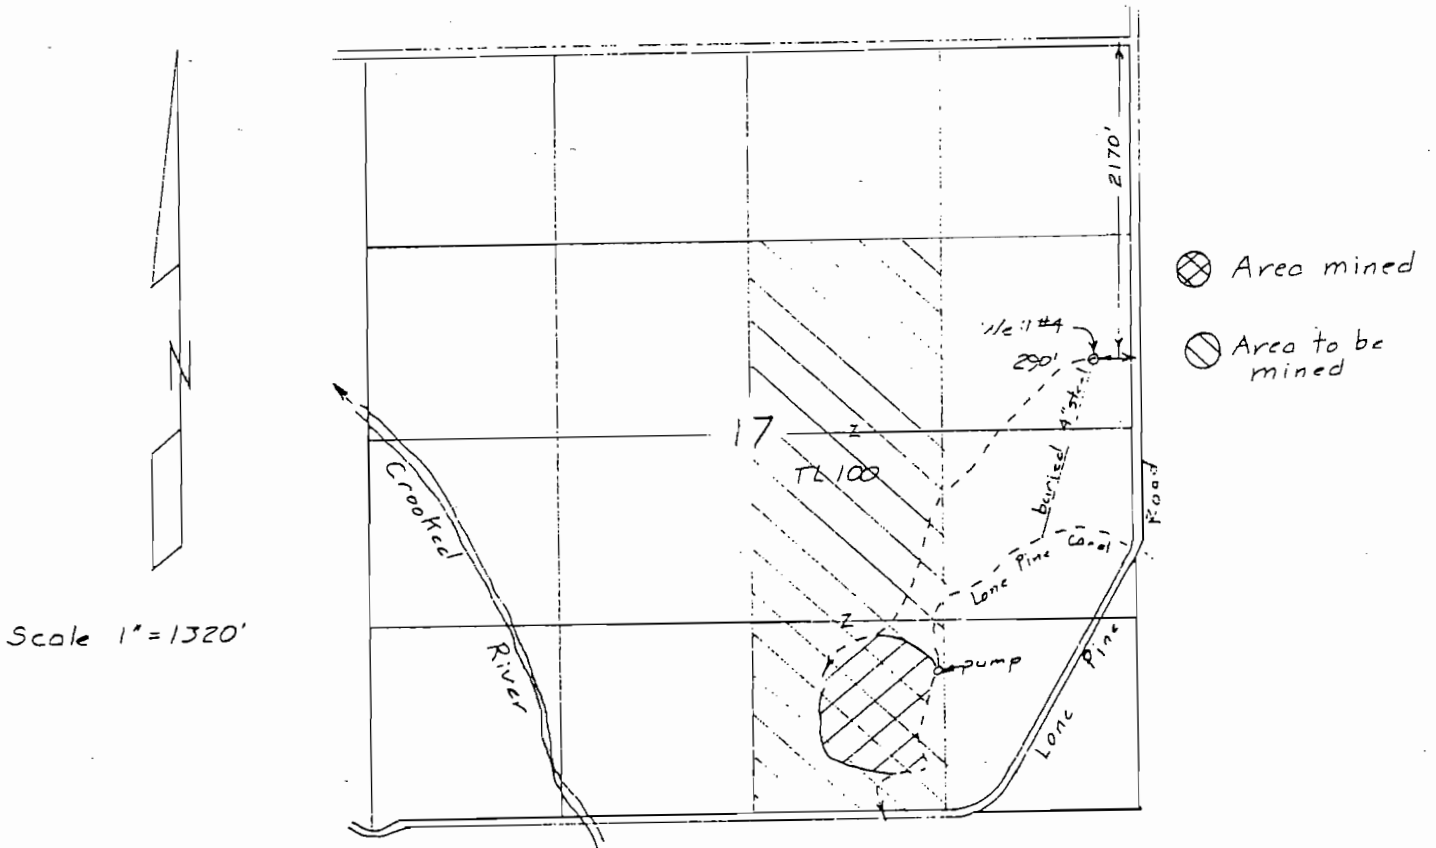

Surveyed September 24, 1998

Claim of Beneficial Use Map  
for  
TY FEHRENBACHER

Application G-13984  
Permit G-12923

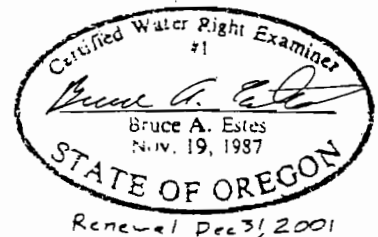

This map is for the purpose of  
locating a water right only  
and has no intent to provide  
legal dimensions or the location  
of property lines.

**ESTES SURVEYS**

PO Box 17519      60382 Arnold Rd  
Salem, OR 97305-7519      Bend, OR 97702  
(503) 585-7593      (541) 382-7391