


# T.6S.,R.1W.,W.M.

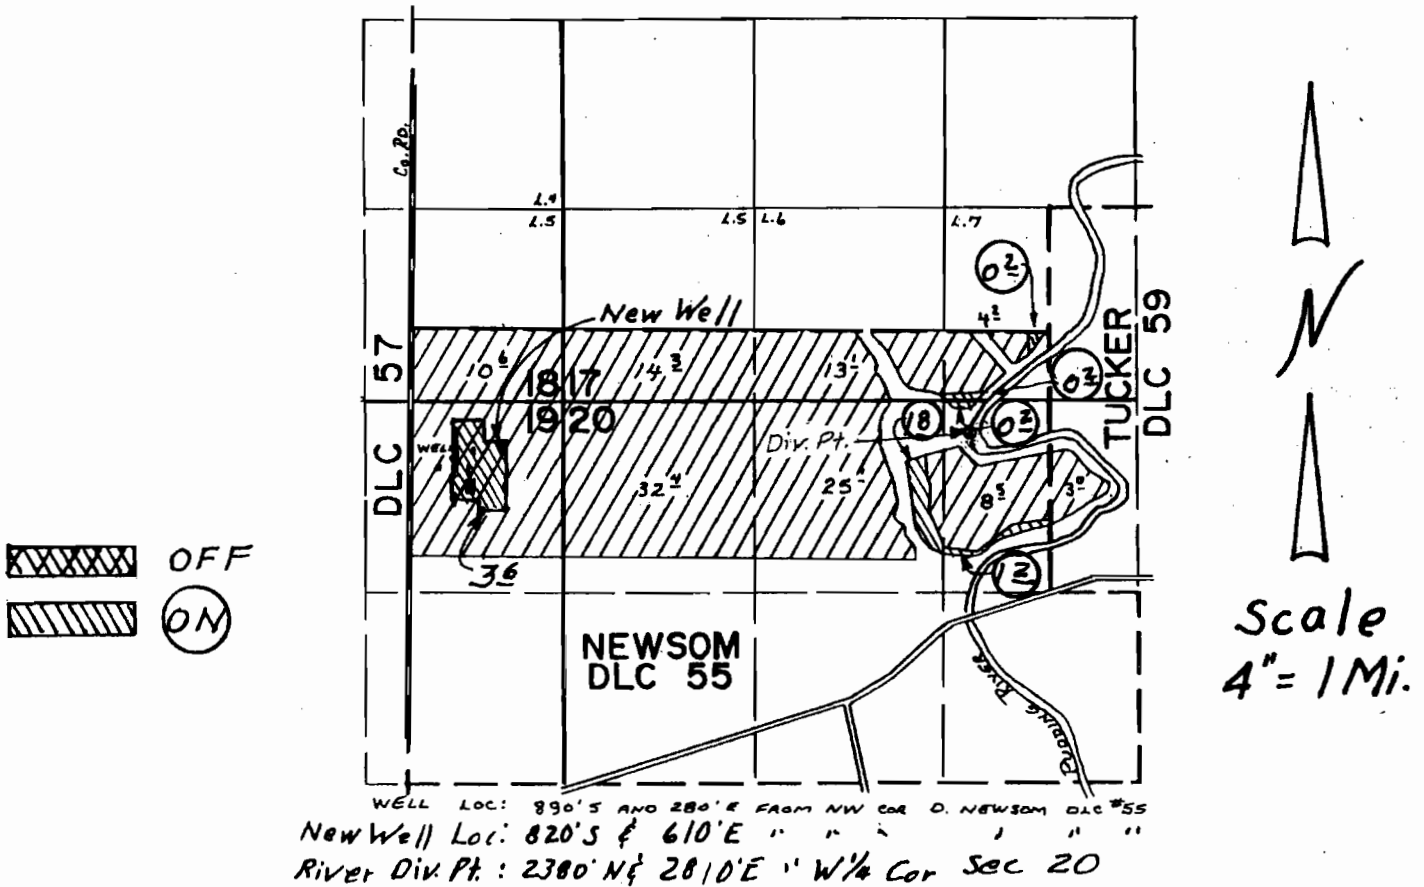

## FINAL PROOF SURVEY

UNDER

TRANSFER NO. T-7904  
IN NAME OF

**DAVID OBERSINNER**

Surveyed August 21, 2001, by

THIS MAP WAS PREPARED FOR THE PURPOSE OF IDENTIFYING THE LOCATION OF A WATER RIGHT ONLY AND IS NOT INTENDED TO PROVIDE LEGAL DIMENSIONS OR LOCATION OF PROPERTY OWNERSHIP LINES.

Certified Water Right Examiner  
 229WRE  
*Larry W. Jebosek*  
 Larry W. Jebosek  
 Dec 7, 1989  
 STATE OF OREGON