


T.38S.,R.10&11E.,W.M.

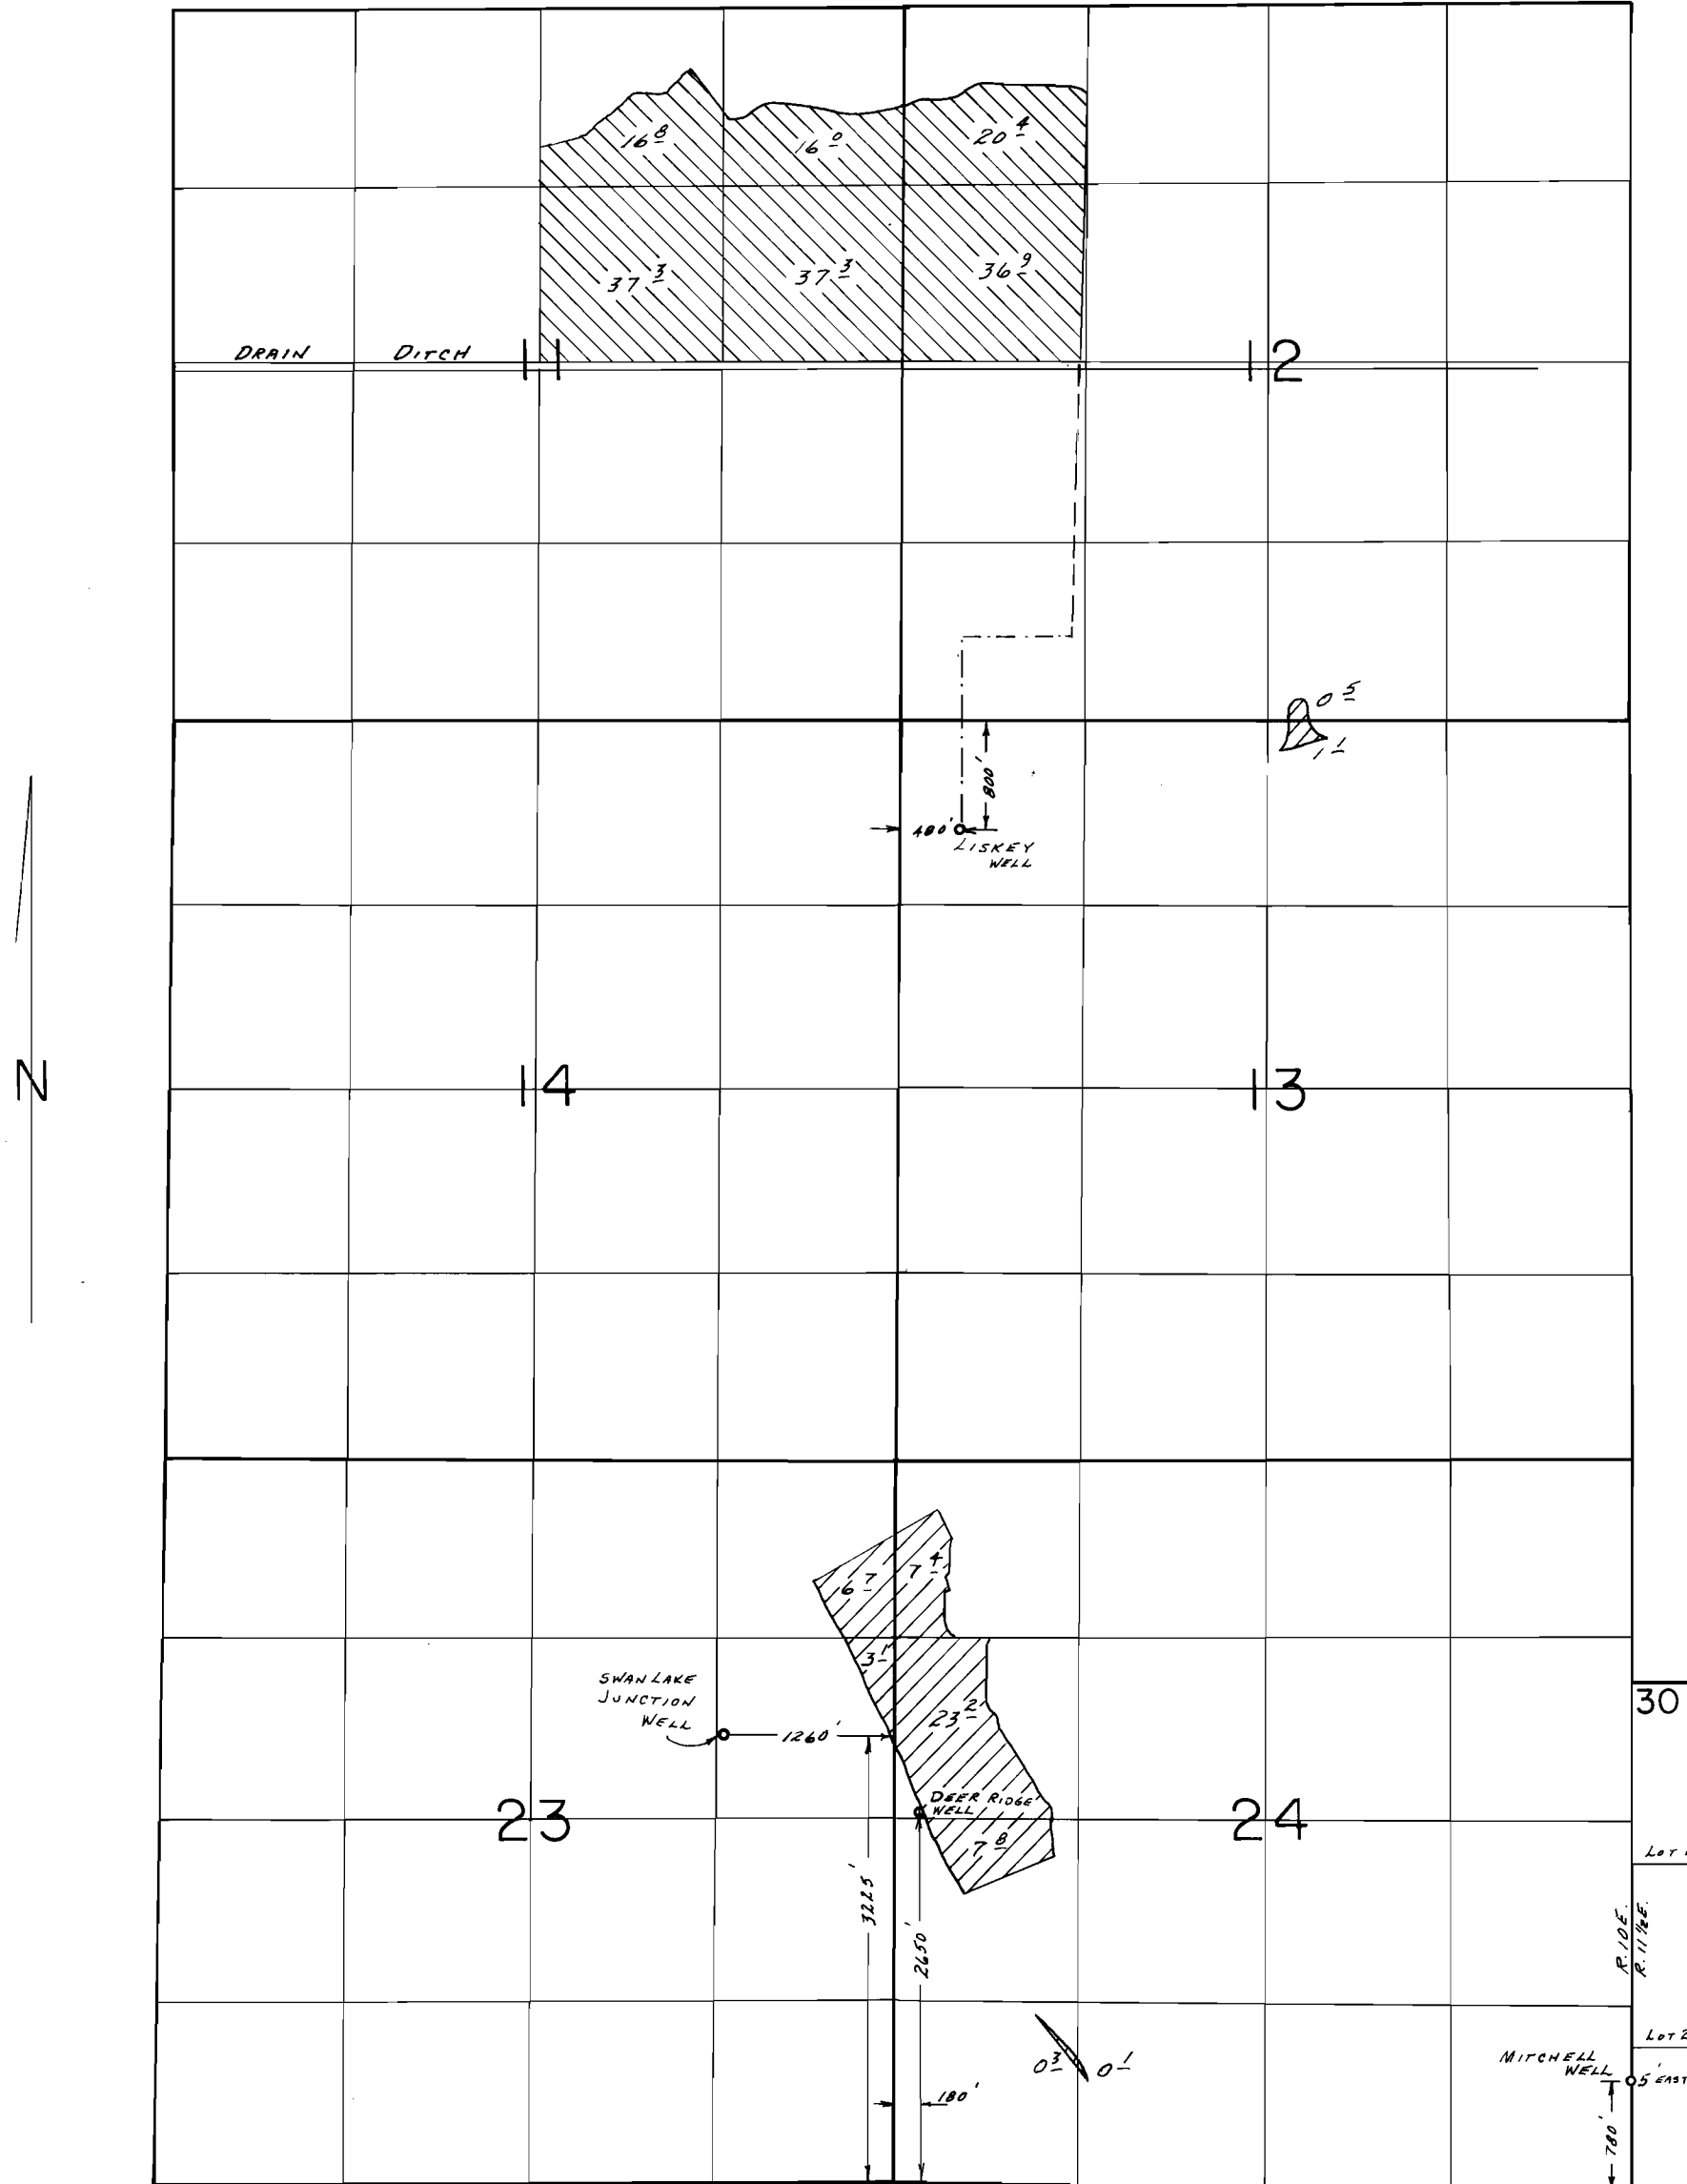

- Permit G-5191 (Liskey Well)
- Permit G-10129 (Liskey Well)
- " " (Deer Ridge Well)
- " " (Mitchell Well)

SCALE: 1" = 1320'

FINAL PROOF SURVEY  
UNDER

Transfer No. 4843  
G-5390 G-5191  
Application No. G-10129 Permit No. G-10129  
IN NAME OF

NEVIN CATTLE COMPANY

Surveyed Oct. 6, 1988, by B.W. BISHOP

C 119